



west elevation

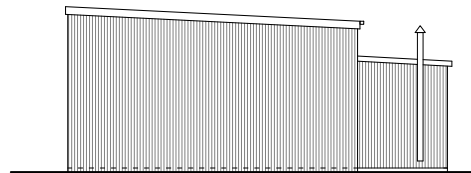


south elevation

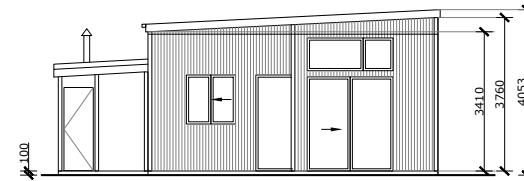

north elevation

FINISHES SCHEDULE

ROOF	Z.A. Custom orb
WALLS Storage	Heritage red Custom orb
Workshop	Z.A. Custom orb
WINDOWS	Chrome Aluminium

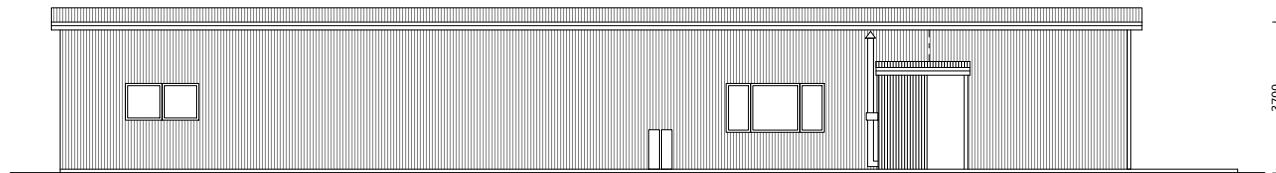

east elevation

AS BUILT
WORKSHOP/ STORAGE SHED

Proposed Eco Resort & Primitive Camping
at 43 Synotts Lane, Ocean Shores

owner

scale
1 : 1000
@ A3


date
Sept 2020

Drawn : David Robinson
128 Old Bangalow Rd
Byron Bay, 2481
ph : 0419 880048
email : divrobinson@gmail.com




Issue A

9
11

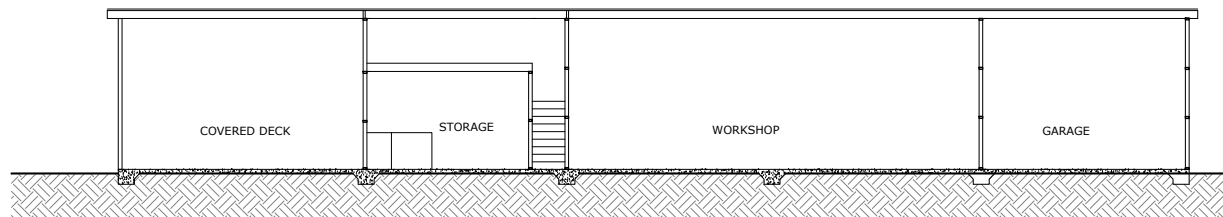

section A-A

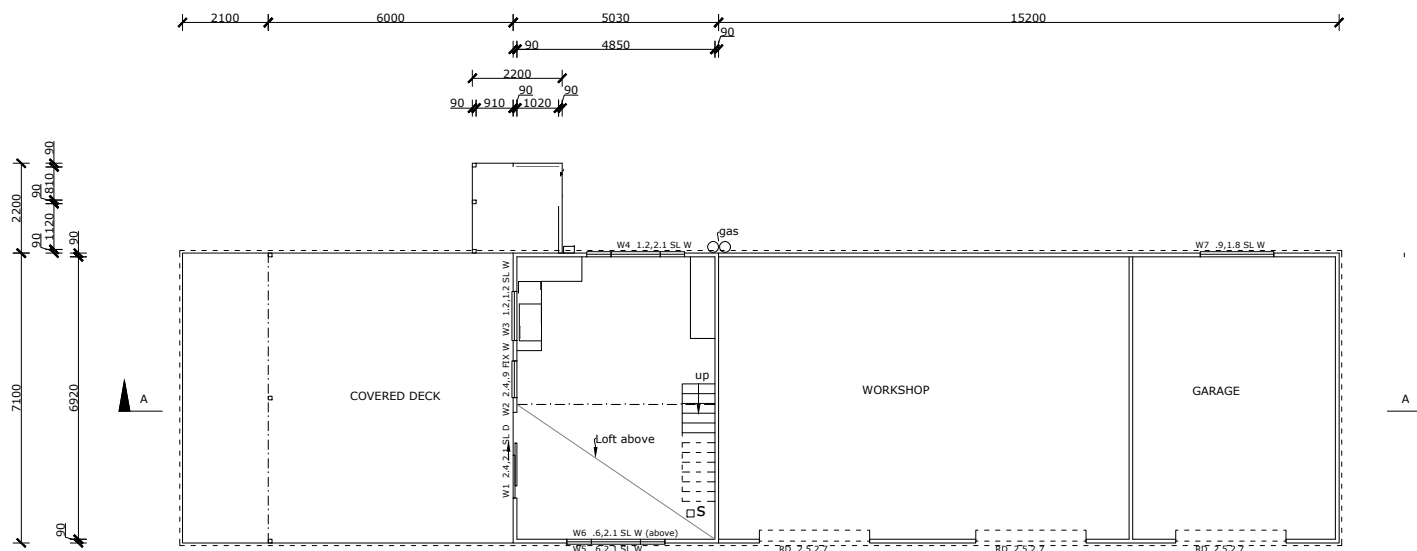

Floor Plan

ELECTRICAL LEGEND
 □ S Selected ceiling mounted, self contained smoke detector
 Hard wired to mains power. Complying with AS 3786

owner

AS BUILT
 WORKSHOP/ STORAGE SHED

Proposed Eco Resort & Primitive Camping
 at 43 Synotts Lane, Ocean Shores

scale
 1 : 1000
 @ A3


date
 Sept 2020

Drawn : David Robinson
 128 Old Bangalow Rd
 Byron Bay, 2481
 ph : 0419 880048
 email : divrobinson@gmail.com




Issue A


8
 11

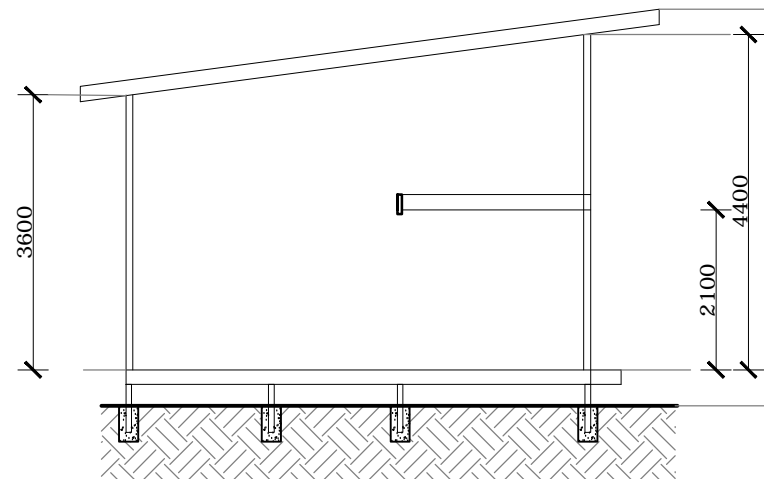


section A-A

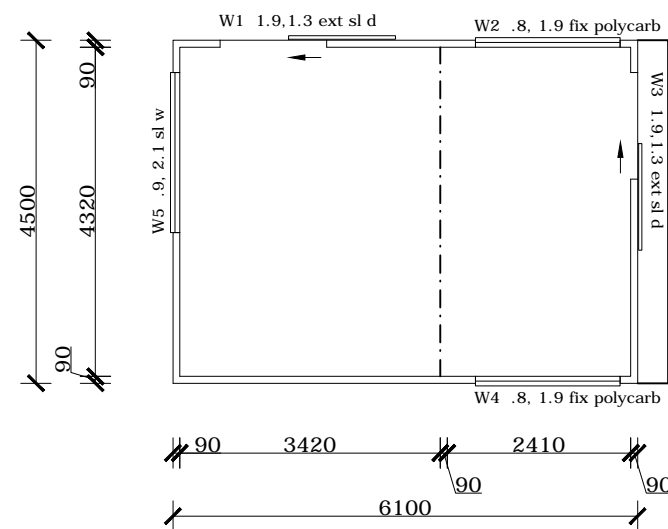


Floor Plan

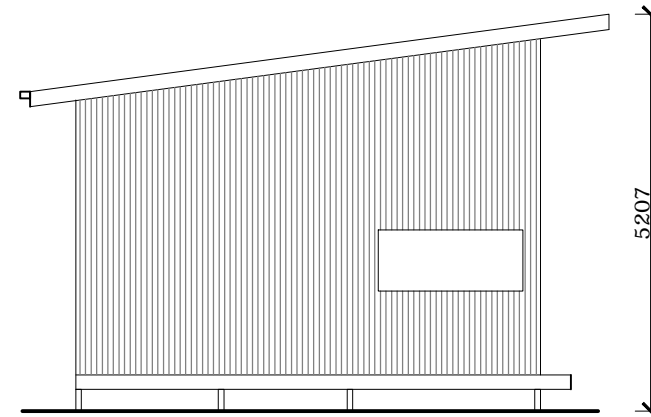


south elevation

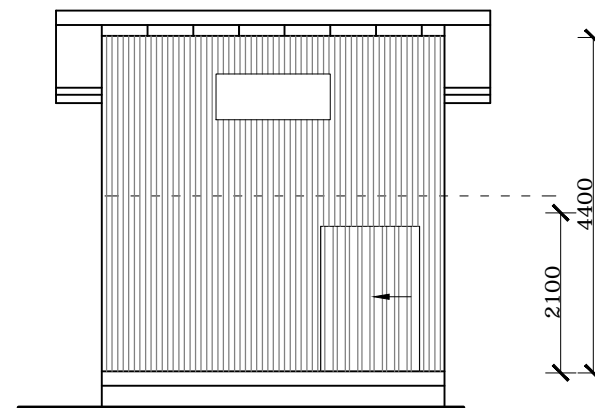

east elevation

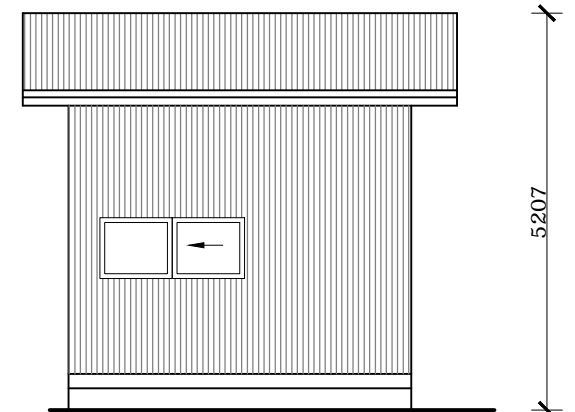

west elevation

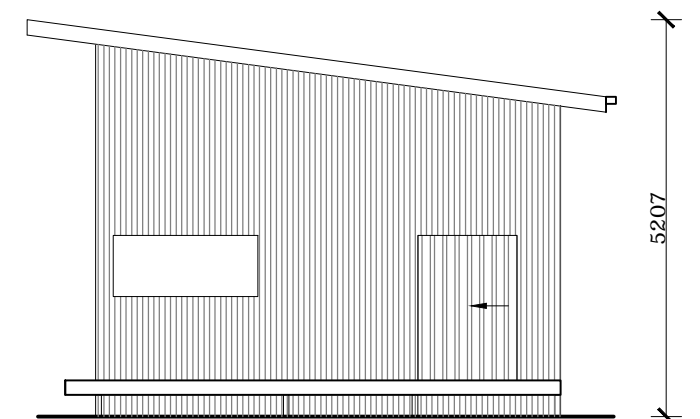

north elevation

FINISHES SCHEDULE

WALLS	Z.A. Corrugated iron
WINDOWS	Timber framed polycarbonate
Doors-	Solid timber external track sliders

BUILDINGS LEGEND

WS

WORKSHOP

P

PERGOLA

A1

AMENITIES 1

A2

AMENITIES 2 (relocate)

SS

STORAGE SHED

wt

WATER TANKS

6.0 x 2.5 PARKING SPACE

3000 with 3.0m DRIVE

RECREATIONAL AREAS


PRIMITIVE CAMPING

CAMPING AREAS 1-10

B.D.A.R. AREA

ZONED RU2

ECO TOURIST FACILITY

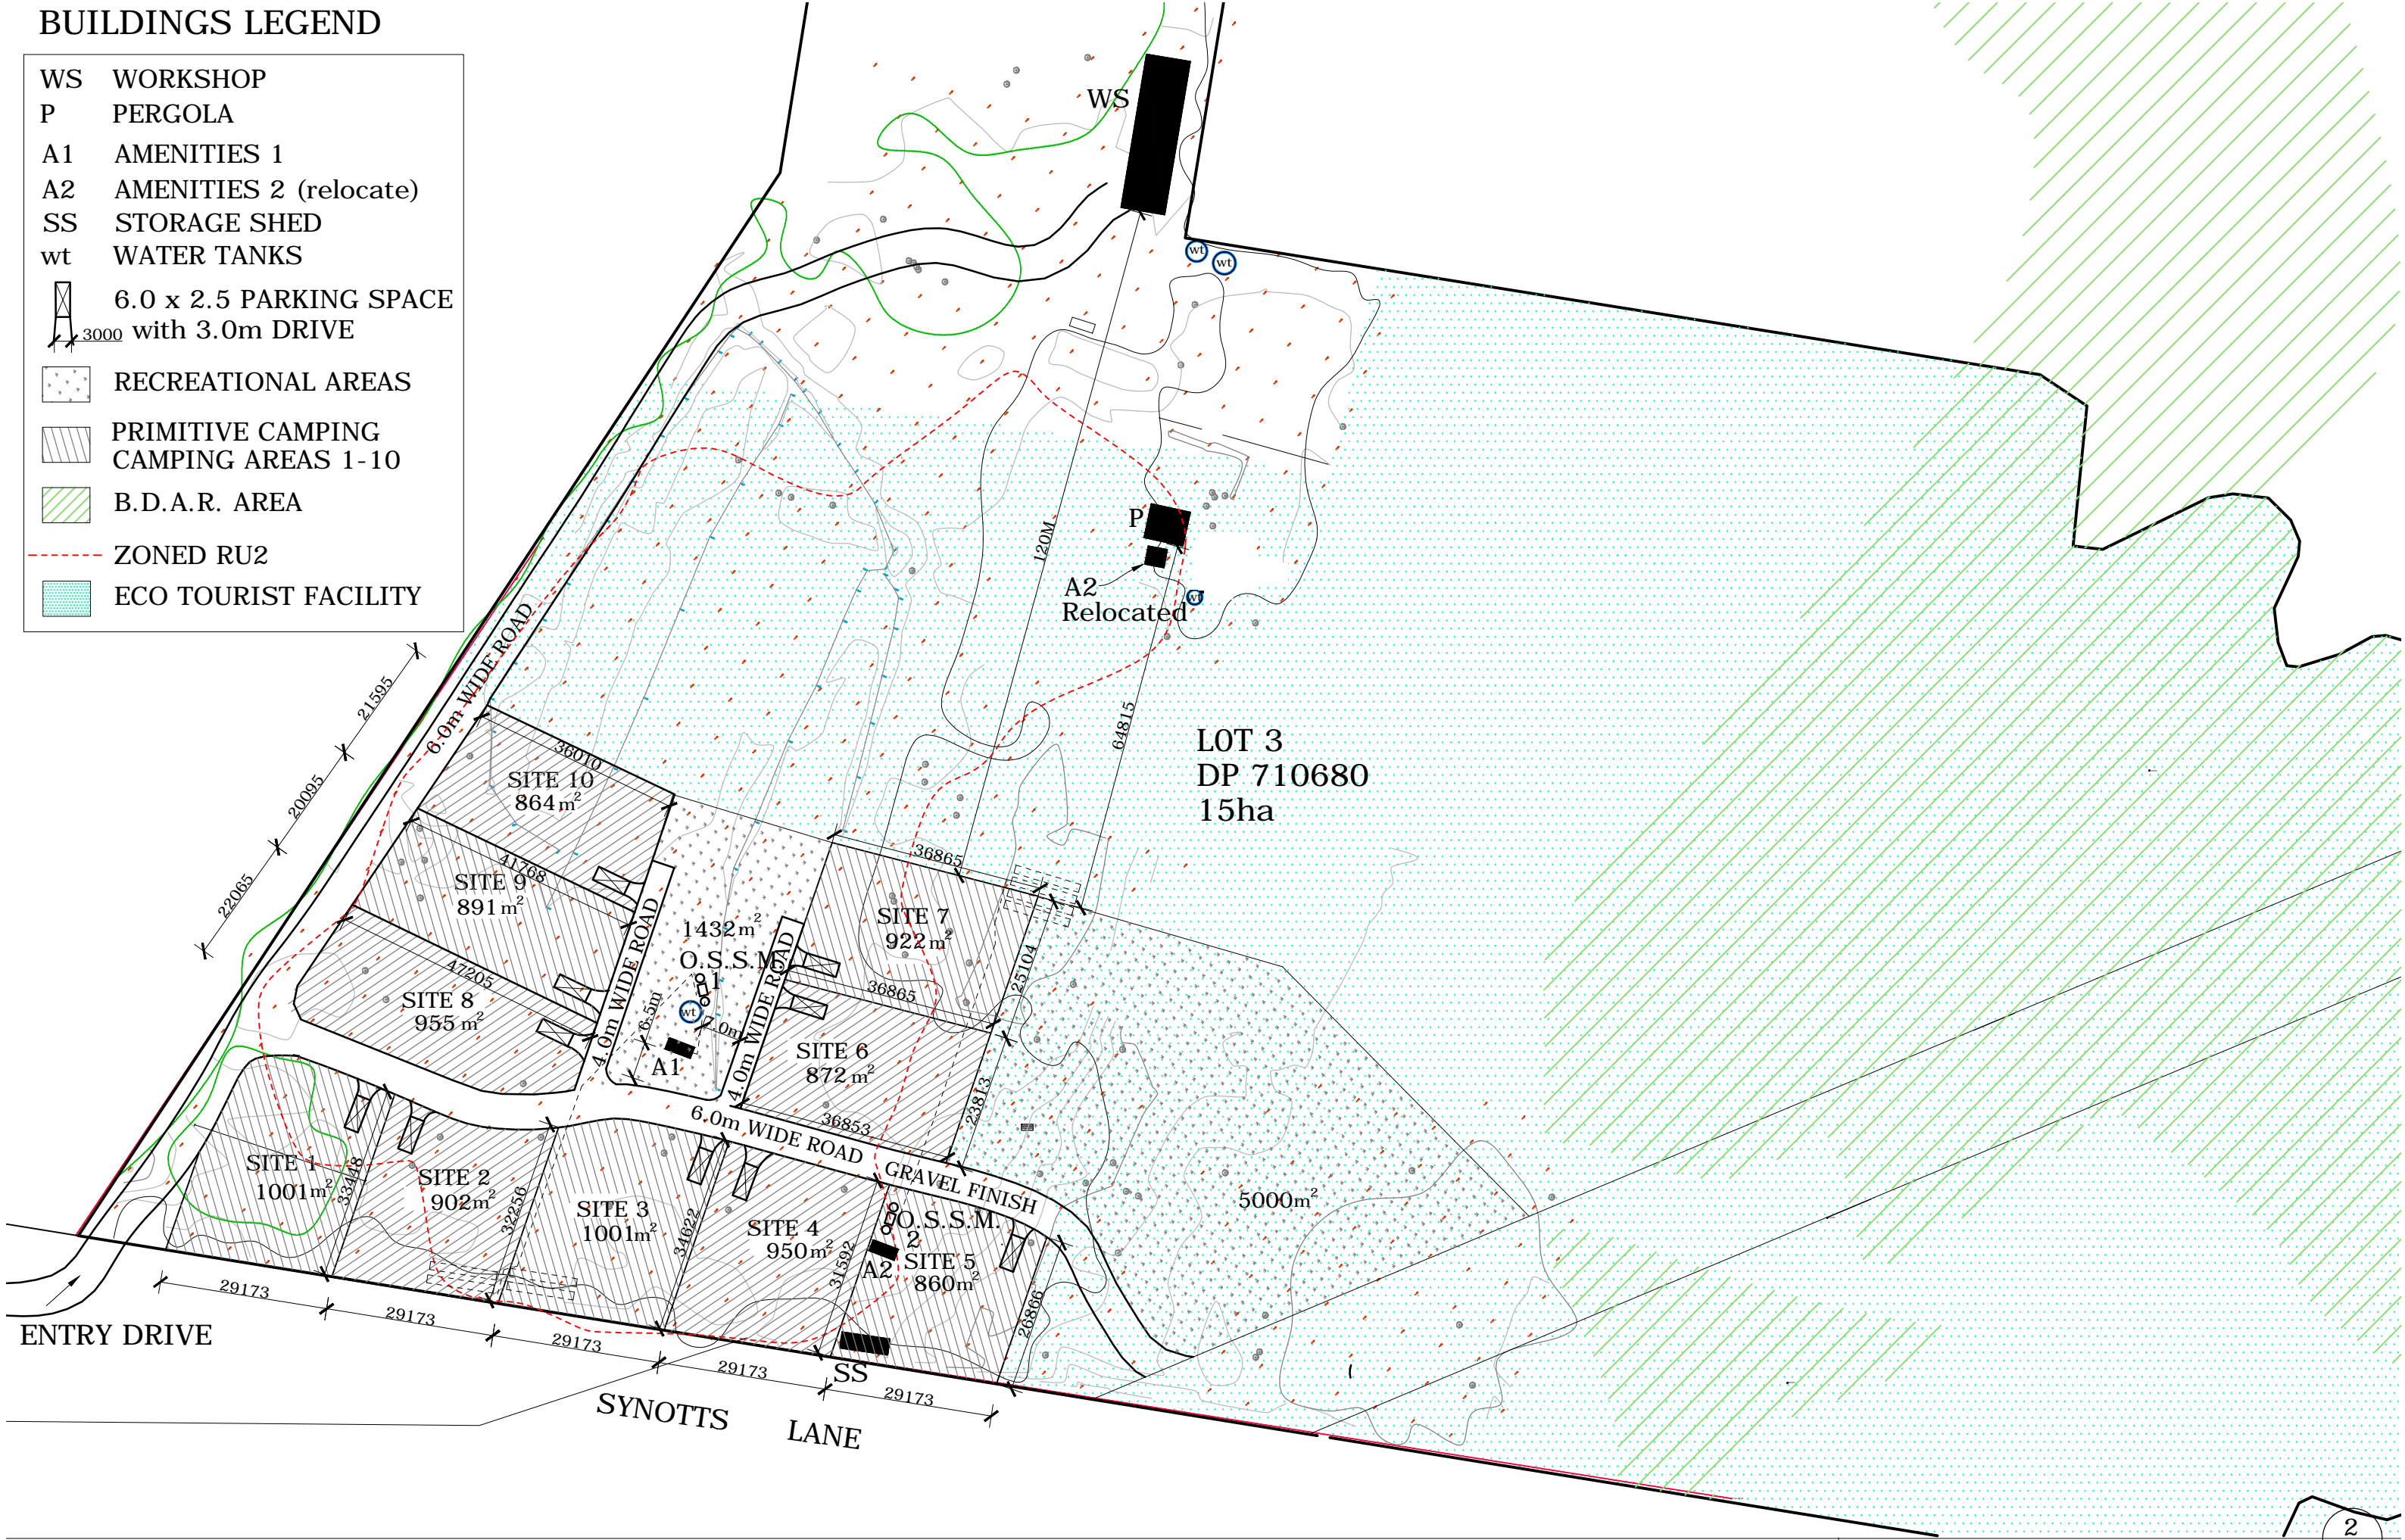

PROPOSED LAYOUT
SITE PLAN

Proposed Primitive Camping
at 43 Synotts Lane, Ocean Shores

owner

scale
1 : 1000
@ A3

date
Feb 2021

128 Old Bangalow Rd
Byron Bay , 2481
ph : 0419 880048
email : divrobinson@gmail.com



Issue B

AS BUILT
AMENITIES BLOCK

Proposed Eco Resort & Primitive Camping
at 43 Synotts Lane, Ocean Shores

owner -----

scale
1 : 1000
@ A3

date
Sept 2020

Drawn : David Robinson
128 Old Banglew Rd
Byron Bay , 2481
ph : 0419 880048
email : divrobinson@gmail.com




Issue A


3
11

ELECTRICAL LEGEND
□ S Selected ceiling mounted, self contained smoke detector
□ S Hard wired to mains power. Complying with AS 3786


Ground Floor Plan

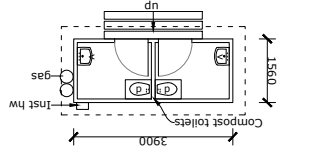


section A-A

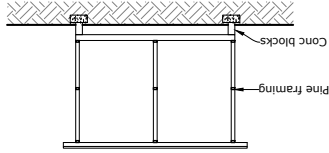


FINISHES SCHEDULE
ROOF Z.A. Custom orb
WALLS Z.A. Custom orb

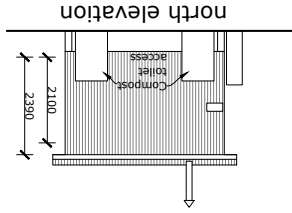


south elevation

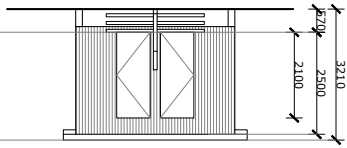


west elevation

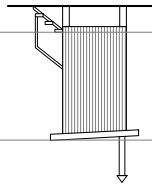

east elevation

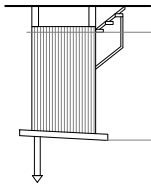

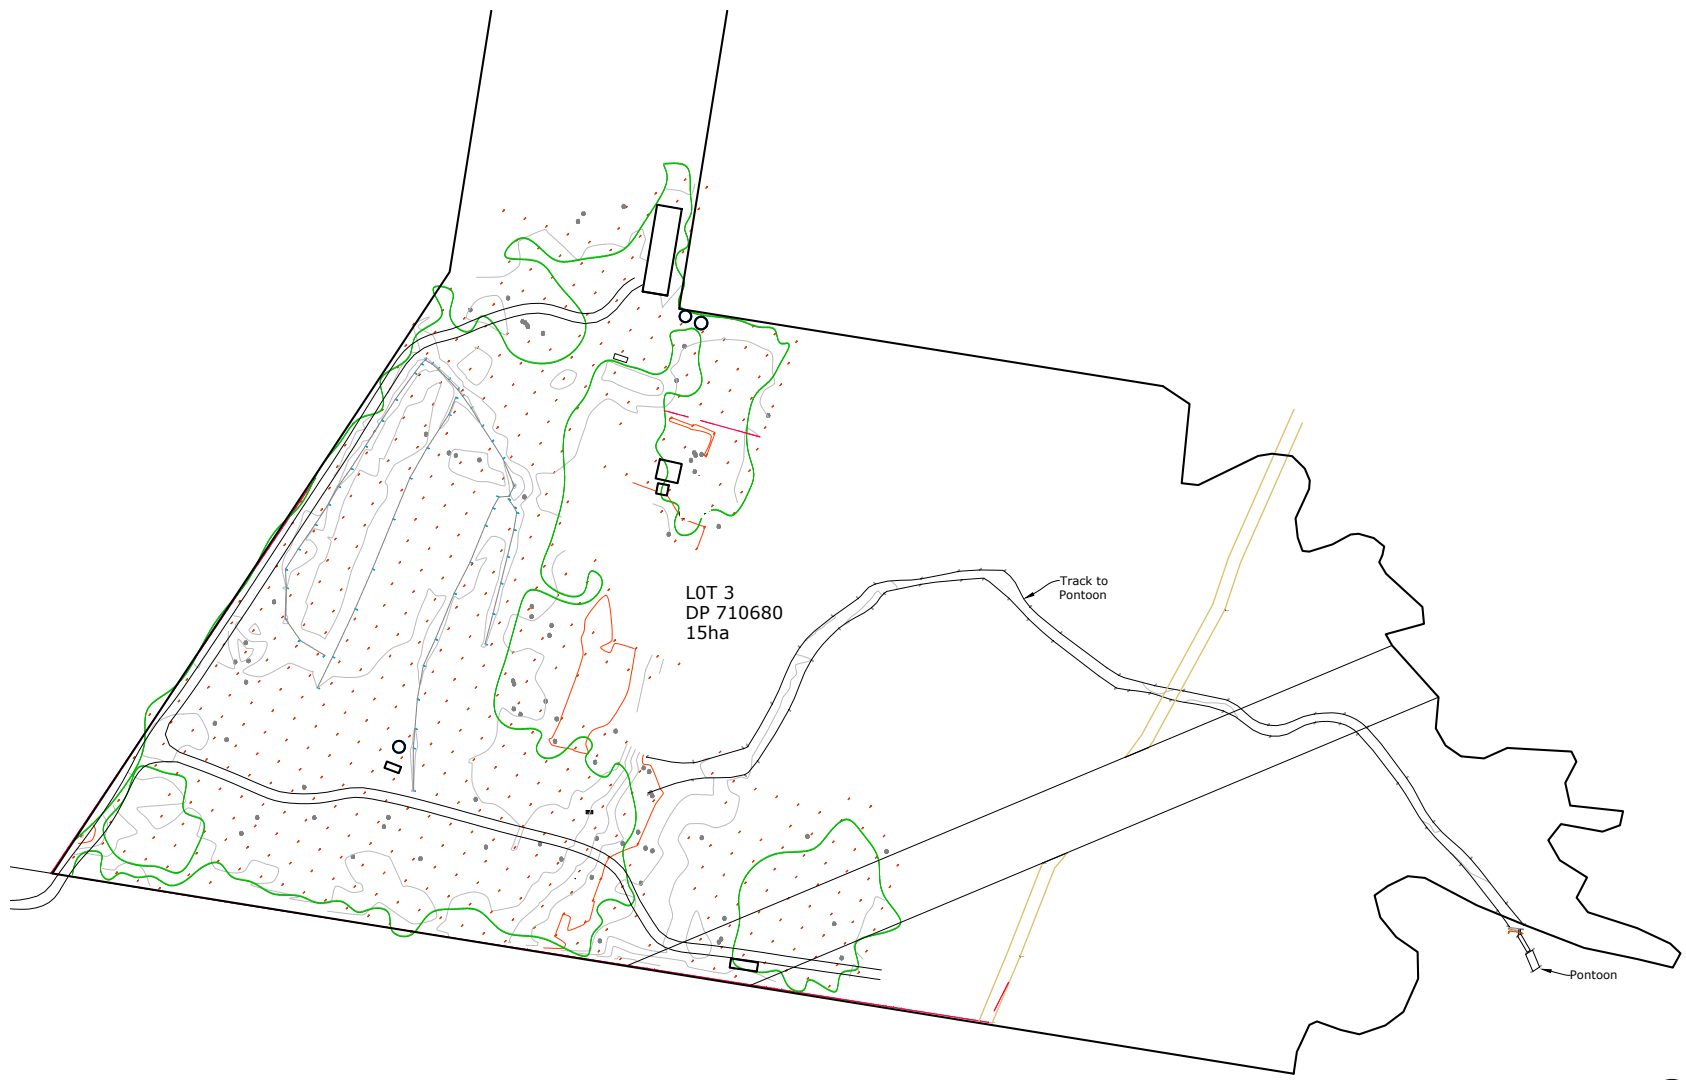

EXISTING CONDITIONS
SITE SURVEY by Cantys

Proposed Eco Resort & Primitive Camping
at 43 Synotts Lane, Ocean Shores

owner

scale
1 : 1250
@ A3

date
Sept 2020
NORTH

Drawn : David Robinson
128 Old Bangalow Rd
Byron Bay , 2481
ph : 0419 880048
email : divrobinson@gmail.com



Issue A