



west elevation

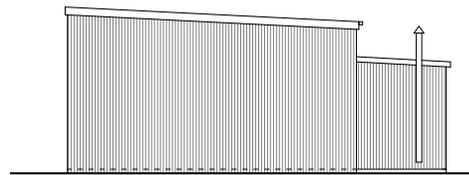


south elevation

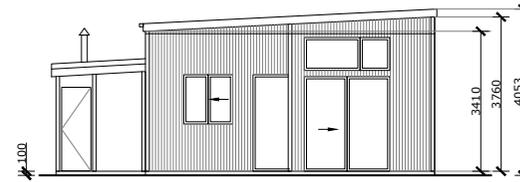

north elevation

FINISHES SCHEDULE

ROOF	Z.A. Custom orb
WALLS Storage	Heritage red Custom orb
Workshop	Z.A. Custom orb
WINDOWS	Chrome Aluminium

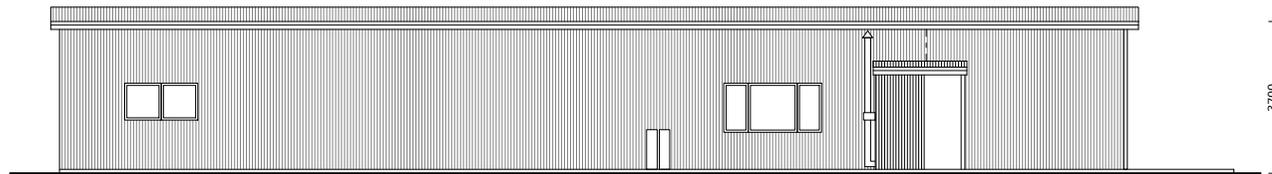

east elevation

AS BUILT
WORKSHOP/ STORAGE SHED

Proposed Eco Resort & Primitive Camping
at 43 Synotts Lane, Ocean Shores

owner


scale
1 : 1000
@ A3

date
Sept 2020



Drawn : David Robinson
128 Old Bungalow Rd
Byron Bay , 2481
ph : 0419 880048
email : divrobinson@gmail.com



Issue A

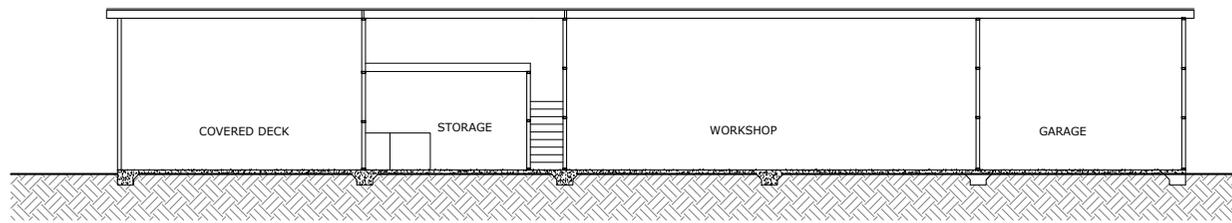

section A-A

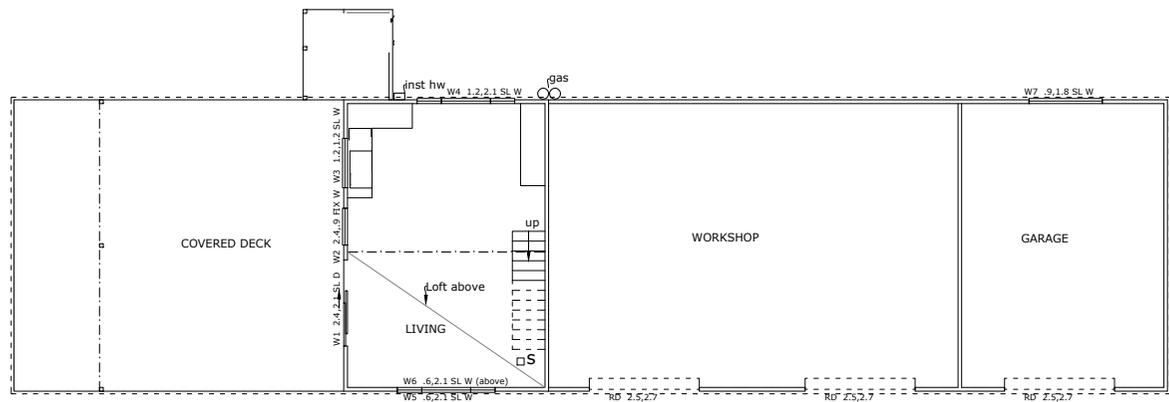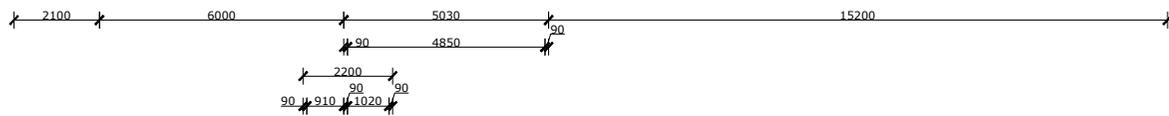

Floor Plan

ELECTRICAL LEGEND
 □S Selected ceiling mounted, self contained smoke detector
 Hard wired to mains power. Complying with AS 3786

owner



AS BUILT
 WORKSHOP/ STORAGE SHED

Proposed Eco Resort & Primitive Camping
 at 43 Synotts Lane, Ocean Shores


scale
 1 : 1000
 @ A3

date
 Sept 2020


Drawn : David Robinson
 128 Old Bangalow Rd
 Byron Bay , 2481
 ph : 0419 880048
 email : divrobinson@gmail.com




Issue A

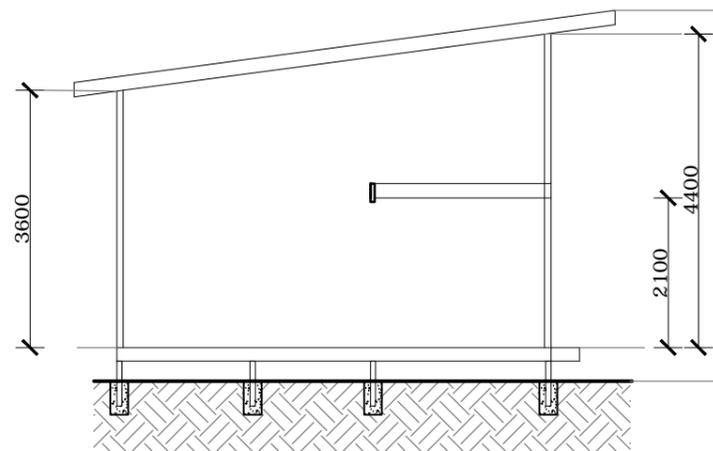


section A-A

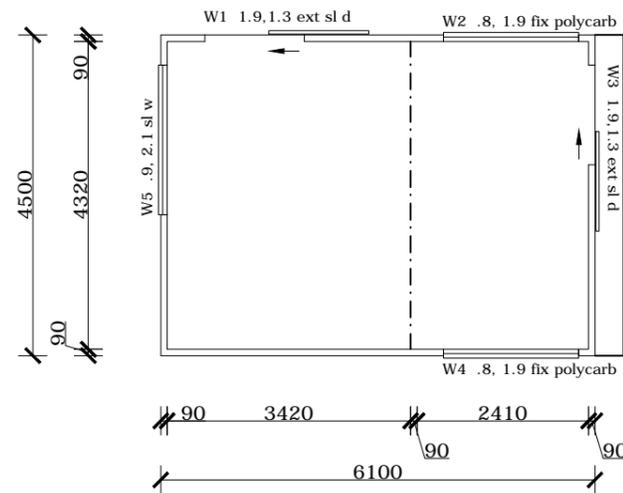


Floor Plan

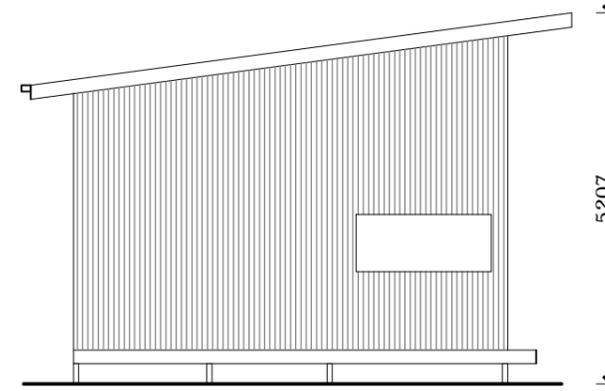


south elevation

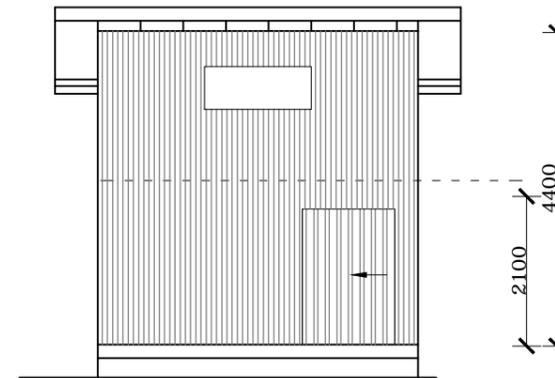

east elevation

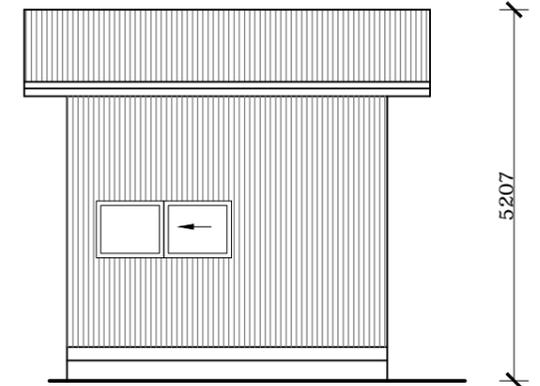

west elevation

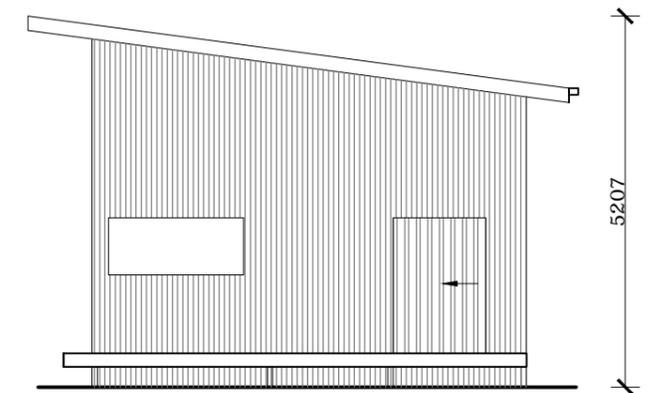

north elevation

FINISHES SCHEDULE

WALLS	Z.A.Corrugated iron
WINDOWS	Timber framed polycarbonate
Doors-	Solid timber external track sliders

BUILDINGS LEGEND

- WS WORKSHOP
- P PERGOLA
- A1 AMENITIES 1
- A2 AMENITIES 2 (relocate)
- SS STORAGE SHED
- wt WATER TANKS
-  6.0 x 2.5 PARKING SPACE with 3.0m DRIVE
-  RECREATIONAL AREAS
-  PRIMITIVE CAMPING CAMPING AREAS 1-10
-  B.D.A.R. AREA
-  ZONED RU2



PROPOSED LAYOUT
SITE PLAN

Proposed Primitive Camping
at 43 Synotts Lane, Ocean Shores

owner

scale
1 : 1000
@ A3

date
Feb 2021

128 Old Bangalow Rd
Byron Bay, 2481
ph : 0419 880048
email : divrobinson@gmail.com




Issue B

28

**EXISTING CONDITIONS
SITE SURVEY by Cantys**

Proposed Eco Resort & Primitive Camping
at 43 Synotts Lane, Ocean Shores

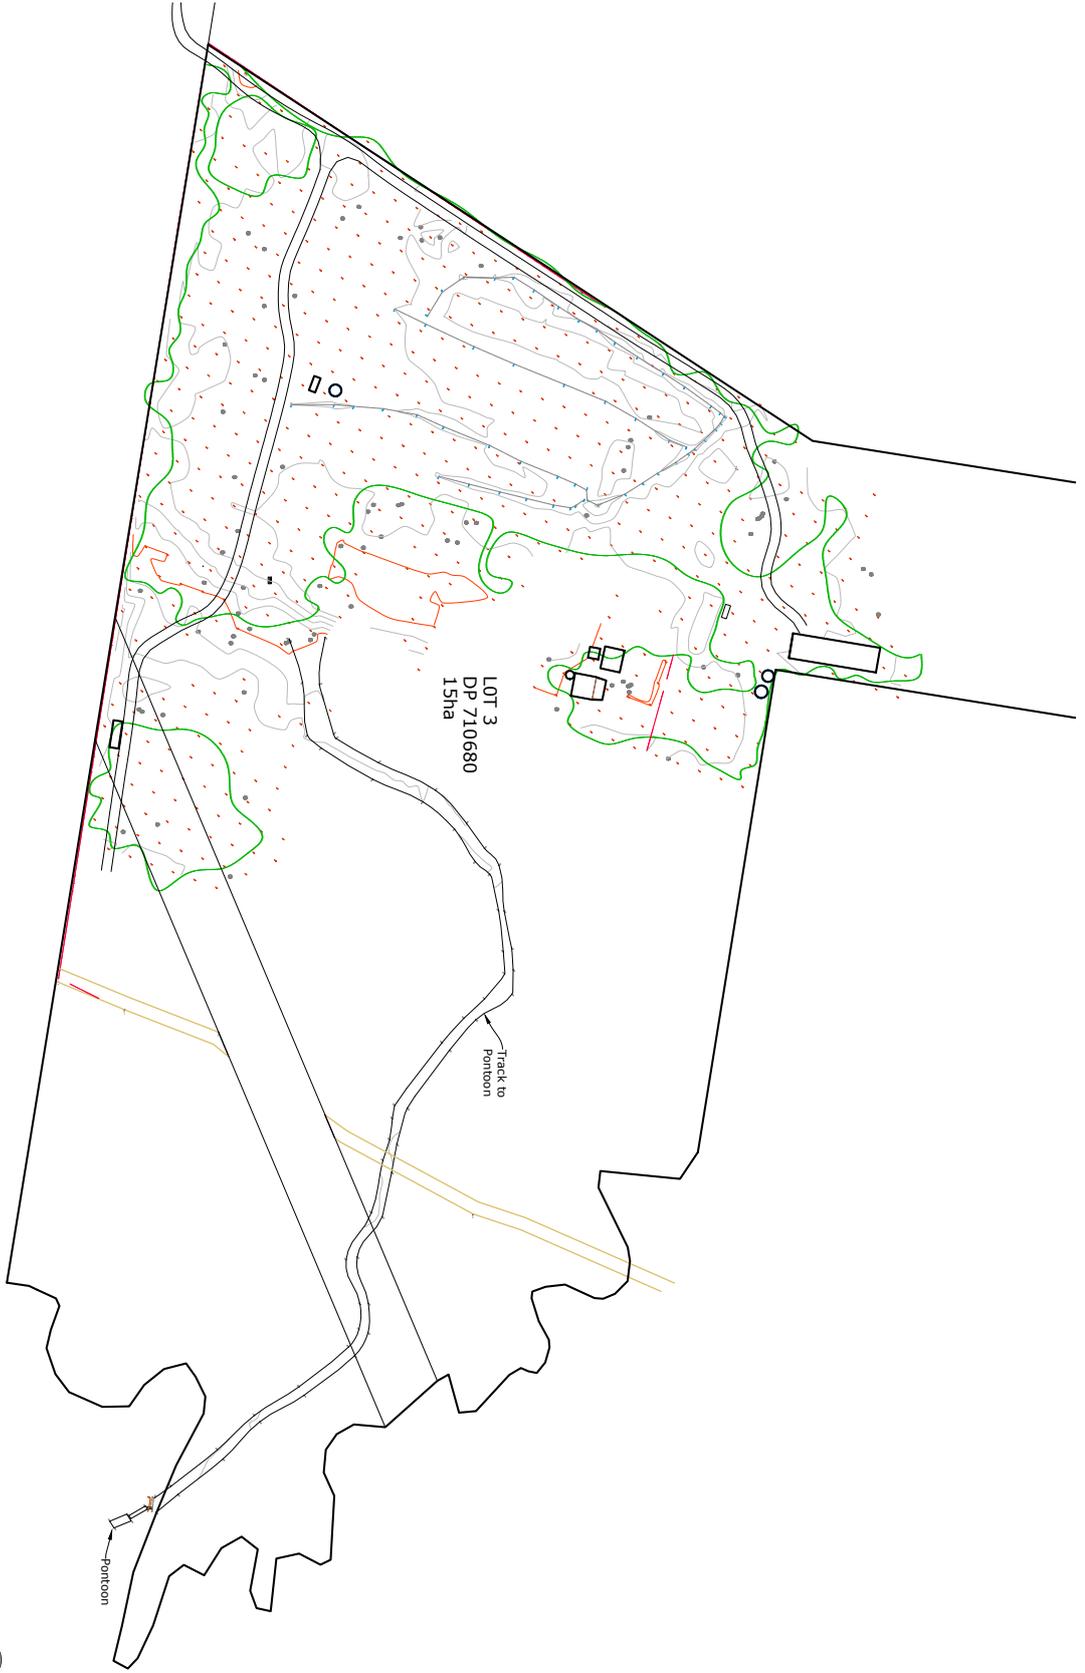

owner




scale
1 : 1250
@ A3

date
Sept 2020
NDRTH

Drawn: David Robinson
Byron Bay Rd
ph: 0419 880048
email: divrobinson@gmail.com



Issue A

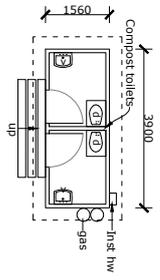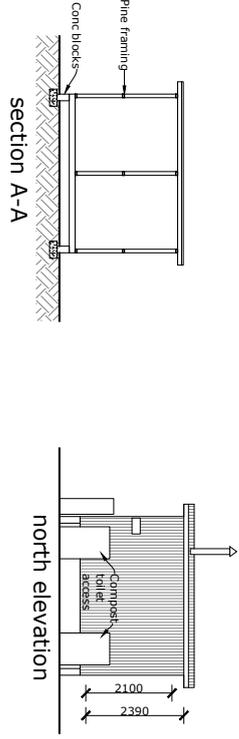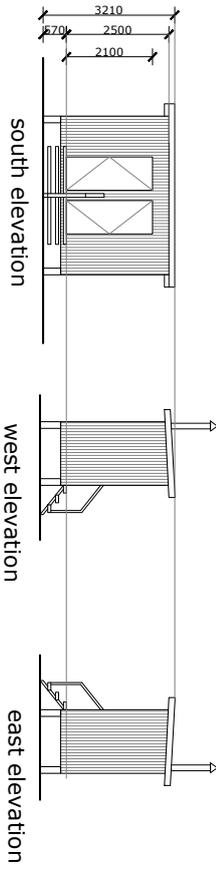

Ground Floor Plan

- ELECTRICAL LEGEND**
- Selected ceiling mounted, self contained smoke detector
 - S Hard wired to mains power. Complying with AS 3786

FINISHES SCHEDULE

ROOF	Z.A. Custom orb
WALLS	Z.A. Custom orb

**AS BUILT
AMENITIES BLOCK**

Proposed Eco Resort & Primitive Camping
at 43 Synotts Lane, Ocean Shores

OWNER
scale 1 : 1000
@ A3
date Sept 2020

Drawn: David Robinson
Byron Bay NSW
ph: 0419 880048
email: divrobinson@gmail.com



Issue A