



west elevation

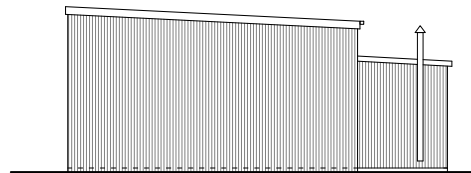


south elevation

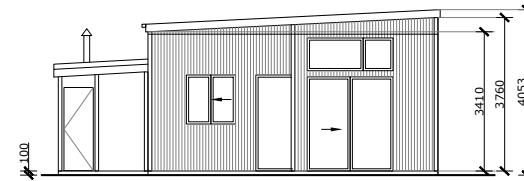

north elevation

FINISHES SCHEDULE

ROOF	Z.A. Custom orb
WALLS Storage	Heritage red Custom orb
Workshop	Z.A. Custom orb
WINDOWS	Chrome Aluminium

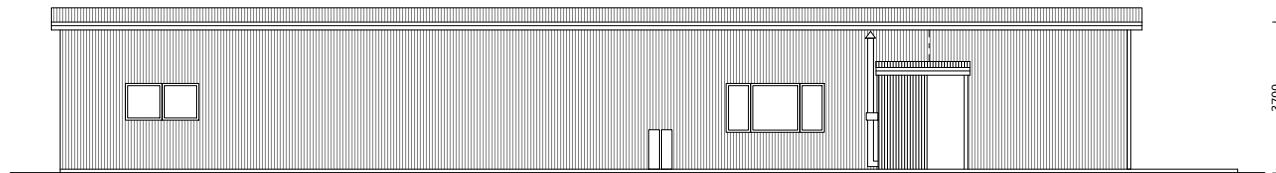

east elevation

AS BUILT  
WORKSHOP/ STORAGE SHED

Proposed Eco Resort & Primitive Camping  
at 43 Synotts Lane, Ocean Shores

owner  
-----



scale  
1 : 1000  
@ A3

date  
Sept 2020

Drawn : David Robinson  
128 Old Bangalow Rd  
Byron Bay, 2481  
ph : 0419 880048  
email : divrobinson@gmail.com



Issue A

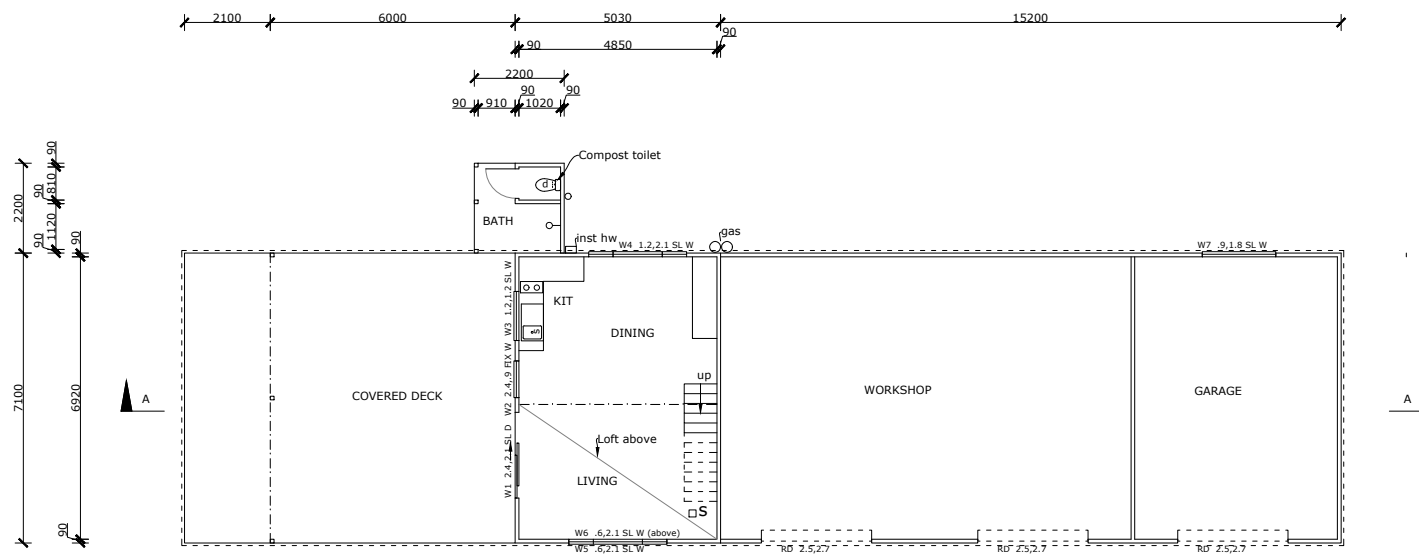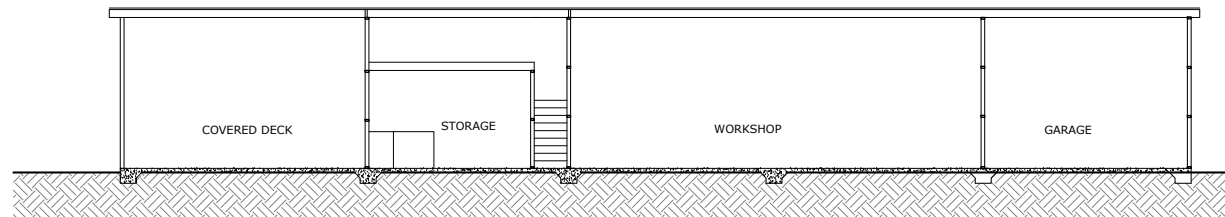

AS BUILT  
WORKSHOP/ STORAGE SHED

## Proposed Eco Resort & Primitive Camping at 43 Synotts Lane, Ocean Shores

owner

scale  
1 : 1000  
@ A3




date  
Sept 2020


Drawn : David Robinson  
128 Old Bangalow Rd  
Byron Bay , 2481  
ph : 0419 880048  
email : divrobinson@gmail.com



Issue A

# BUILDINGS LEGEND

WS	WORKSHOP
A1	AMENITIES 1
A2	AMENITIES 2
SS	STORAGE SHED
wt	WATER TANKS
	6.0 x 2.5 PARKING SPACE
	RECREATIONAL AREAS
	CAMPING AREAS 1-10

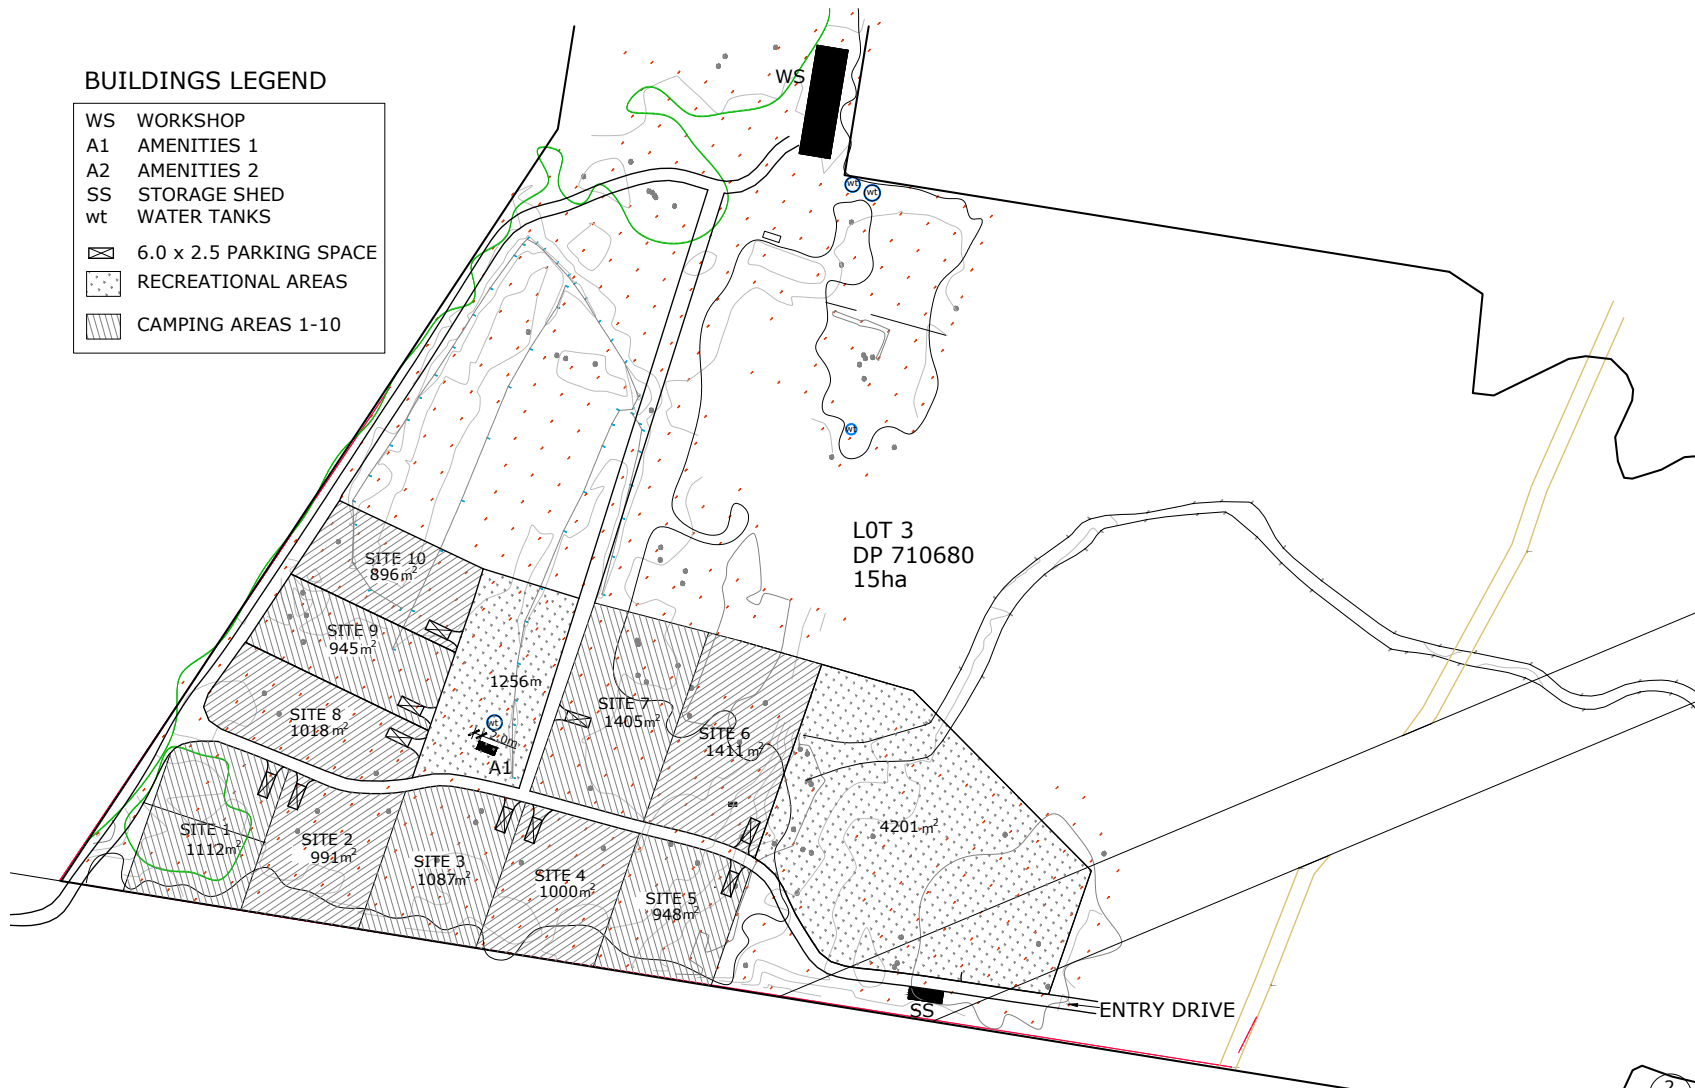

EXISTING / PROPOSED LAYOUT  
SITE PLAN

Proposed Primitive Camping  
at 43 Synotts Lane, Ocean Shores

owner  
c/o Josh Glennon  
Project Manager

scale  
1 : 1000  
@ A3


date  
Sept 2020  
NORTH

128 Old Bangalow Rd  
Byron Bay, 2481  
ph : 0419 880048  
email : divrobinson@gmail.com




Issue A


2  
2

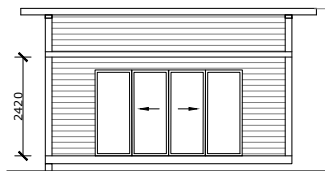


north elevation

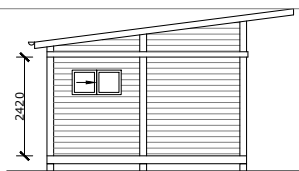

east elevation

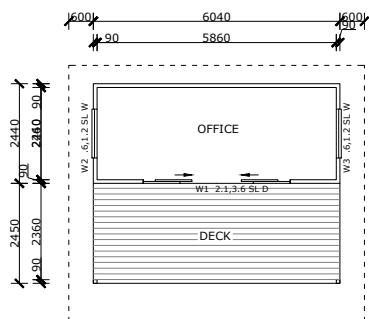

Floor Plan






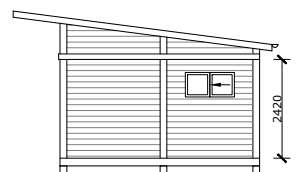


west elevation

AS BUILT  
OFFICE

Proposed Eco Resort & Primitive Camping  
at 43 Synotts Lane, Ocean Shores

owner  
-----

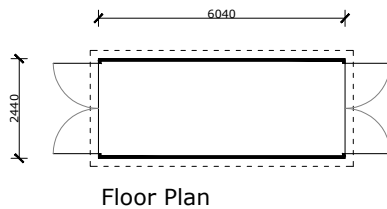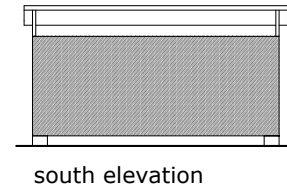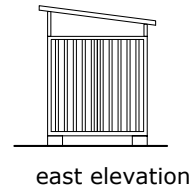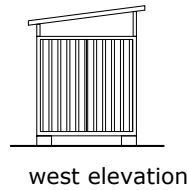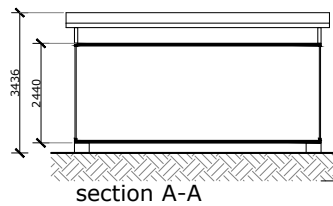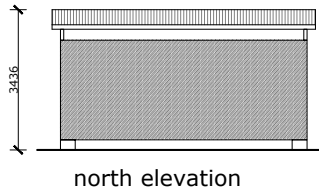

FINISHES SCHEDULE		
ROOF		Z.A. Custom orb
WALLS	East, West	Vert slatted timber gates
	Nth, Sth	Off white steel Ship Container

AS BUILT  
STORAGE SHED

Proposed Eco Resort & Primitive Camping  
at 43 Synotts Lane, Ocean Shores

owner  
-----

scale  
1 : 1000  
@ A3


date  
Sept 2020

Drawn : David Robinson  
128 Old Bangalow Rd  
Byron Bay, 2481  
ph : 0419 880048  
email : divrobinson@gmail.com



Issue A

4  
11

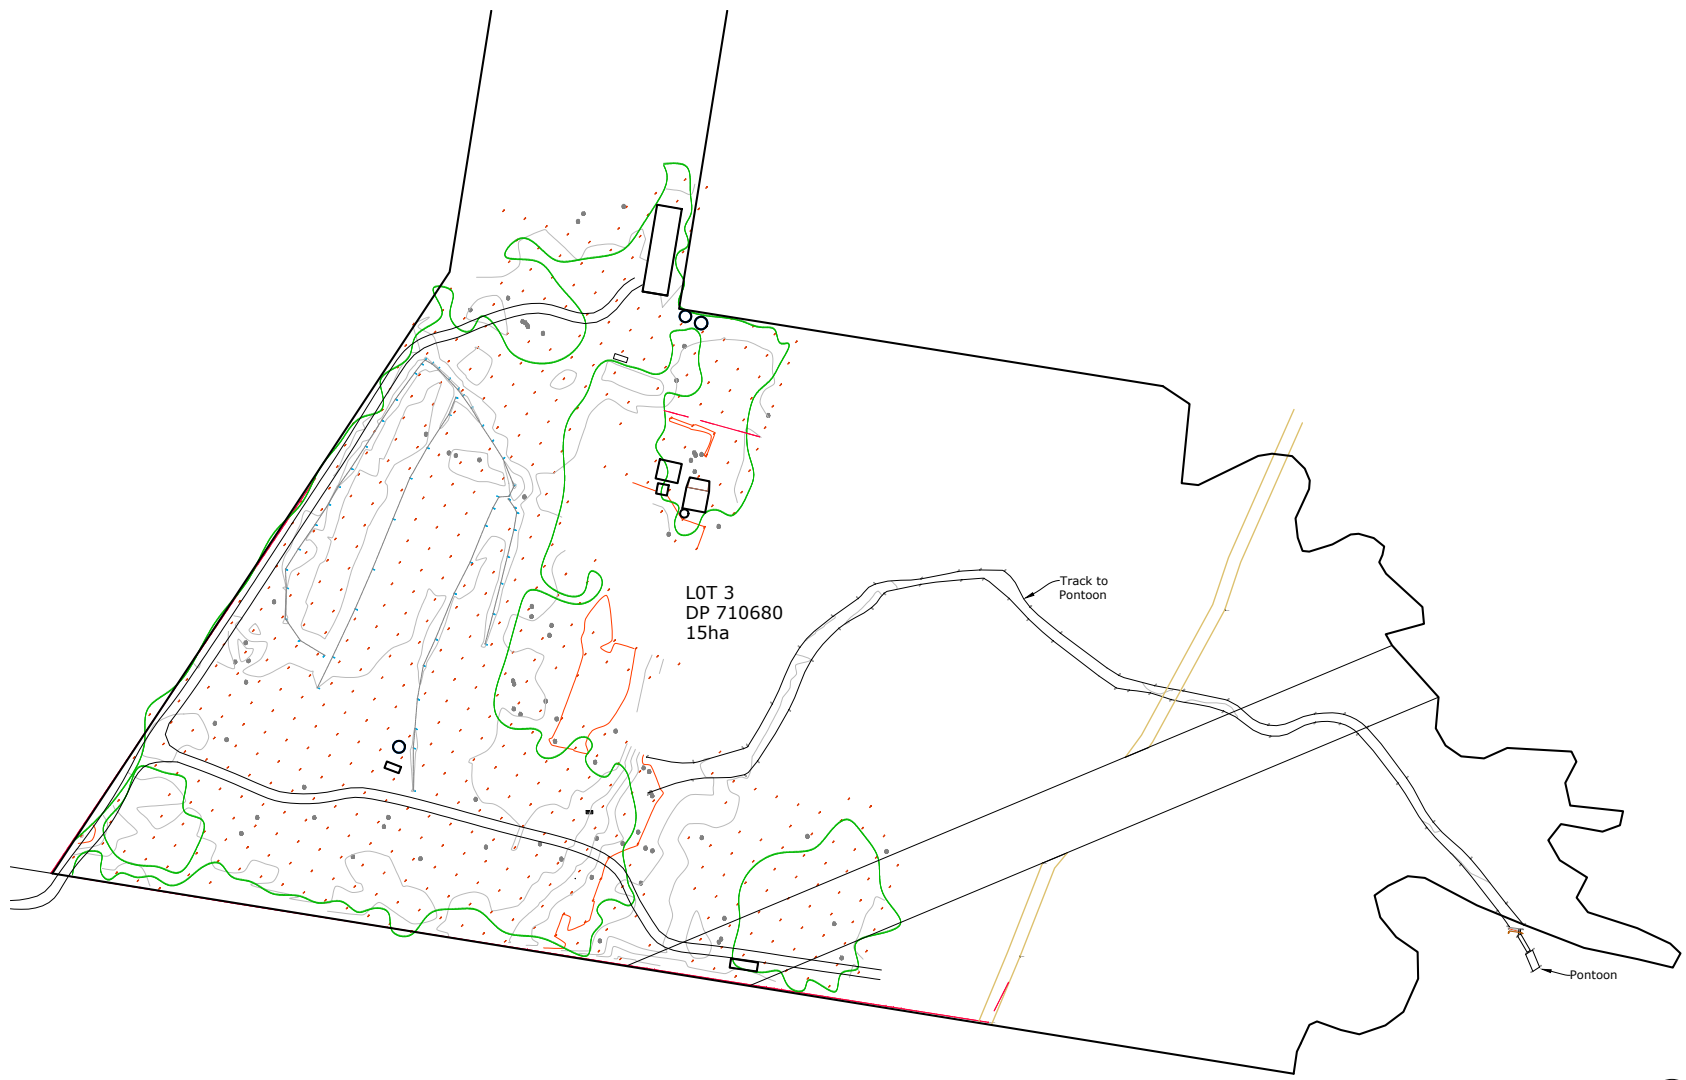

EXISTING CONDITIONS  
SITE SURVEY by Cantys

Proposed Eco Resort & Primitive Camping  
at 43 Synotts Lane, Ocean Shores

owner  
-----




scale  
1 : 1250  
@ A3

date  
Sept 2020  
NORTH

Drawn : David Robinson  
128 Old Bangalow Rd  
Byron Bay , 2481  
ph : 0419 880048  
email : divrobinson@gmail.com



Issue A

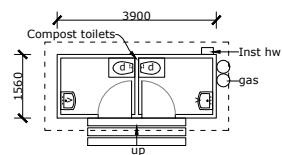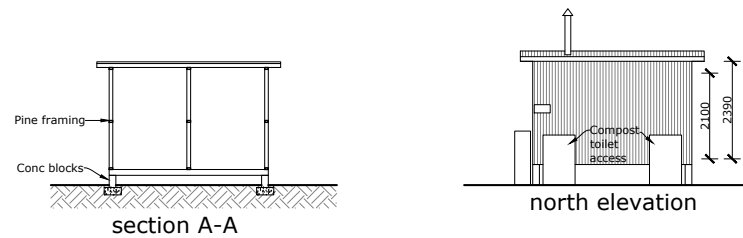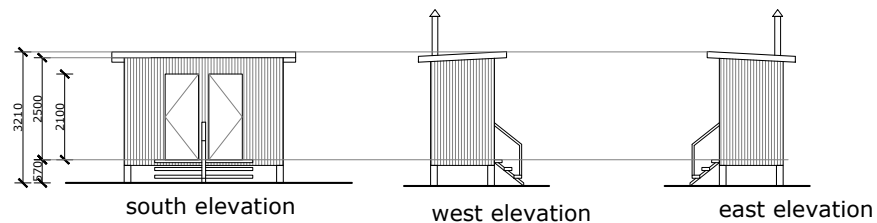

FINISHES SCHEDULE	
ROOF	Z.A. Custom orb
WALLS	Z.A. Custom orb

ELECTRICAL LEGEND  
 □ S Selected ceiling mounted, self contained smoke detector  
 Hard wired to mains power. Complying with AS 3786

AS BUILT  
 AMENITIES BLOCK

Proposed Eco Resort & Primitive Camping  
 at 43 Synotts Lane, Ocean Shores

owner  
 -----

scale  
 1 : 1000  
 @ A3

date  
 Sept 2020

Drawn : David Robinson  
 128 Old Bangalow Rd  
 Byron Bay , 2481  
 ph : 0419 880048  
 email : divrobinson@gmail.com



Issue A