

# BUILDINGS LEGEND

WS	WORKSHOP
A1	AMENITIES 1
A2	AMENITIES 2 (relocate)
WT	WATER TANKS
	6.0 x 2.5 PARKING SPACE
	3000 with 3.0m DRIVE
	RECREATIONAL AREAS
	PRIMITIVE CAMPING
	CAMPING AREAS 1-10
	B.D.A.R. AREA
	ZONED RU2



## PROPOSED LAYOUT SITE PLAN

Proposed Primitive Camping  
at 43 Synnotts Lane, Ocean Shores

OWNER

Scale

1 : 1000

@ A3

date

Feb 2021

128 Old Bangalow Rd


Byron Bay, 2481

ph : 0419 880048

email : divedivision@gmail.com




Issue B

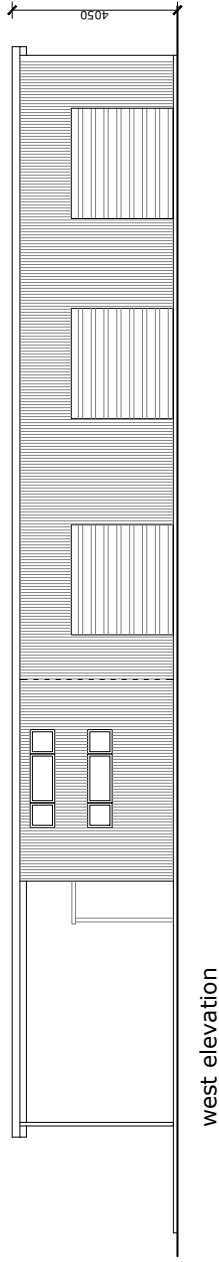

#### FINISHES SCHEDULE

ROOF	Z.A. Custom orb
WALLS	Storage Heritage red Custom orb
Workshop	Z.A. Custom orb
WINDOWS	Chrome Aluminium

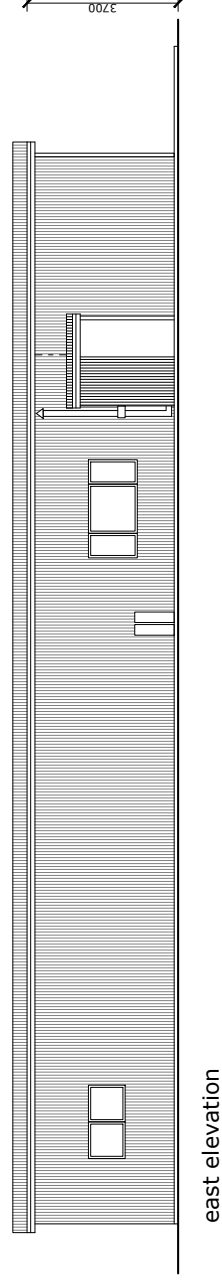

AS BUILT  
WORKSHOP/ STORAGE SHED

Proposed Eco Resort & Primitive Camping  
at 43 Synotts Lane, Ocean Shores

owner  
----




scale  
1 : 1000  
@ A3

date  
Sept 2020

Drawn : David Robinson  
By : David Robinson  
Byron Bay, 2481  
ph : 0419 880048  
email : divrobinson@gmail.com



Issue A

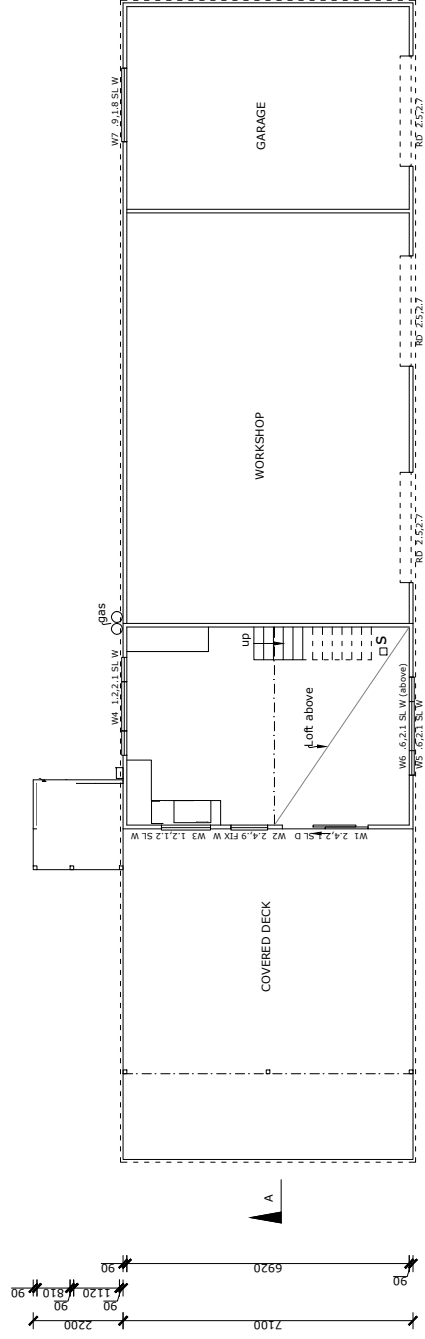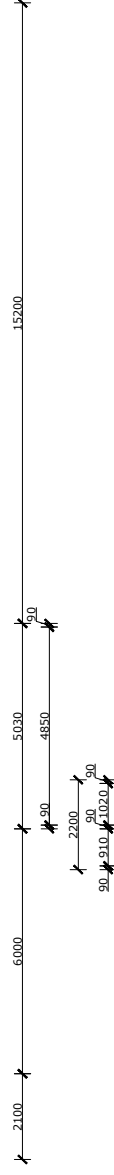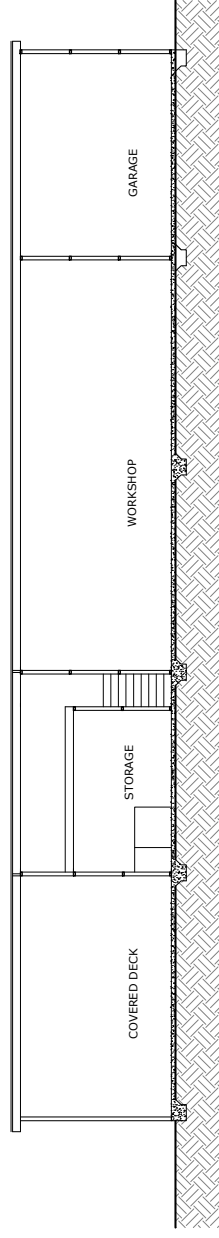

## Floor Plan

### ELECTRICAL LEGEND

Selected ceiling mounted, self contained smoke detector  
Hard wired to mains power. Complying with AS 3786

5 H

Proposed Eco Resort &amp; Primitive Camping

at 43 Synotts Lane, Ocean Shores

owner

owner

scale  
1 : 1000  
@ A3

scale  
1 : 1,000scale  
1 : 1,000

date  
Sept 2020

date  
Sept 2020

Drawn : David Robinson  
128 Old Bangalow Rd  
Byron Bay , 2481  
ph : 0419 880048  
email : divrobinson@gmail.com

Drawn : David Robinson  
128 Old Bangalow Rd  
Byron Bay , 2481  
ph : 0419 880048  
email : divrobinson@gmail.com



Drawn : David Robinson  
128 Old Bangalow Rd  
Byron Bay , 2481  
ph : 0419 880048  
email : divrobinson@gmail.com

Drawn : David Robinson  
128 Old Bangalow Rd  
Byron Bay , 2481  
ph : 0419 880048  
email : divrobinson@gmail.com

Drawn : David Robinson  
128 Old Bangalow Rd  
Byron Bay , 2481  
ph : 0419 880048  
email : divrobinson@gmail.com



## Issue A

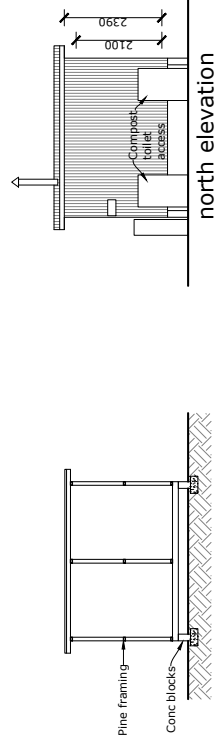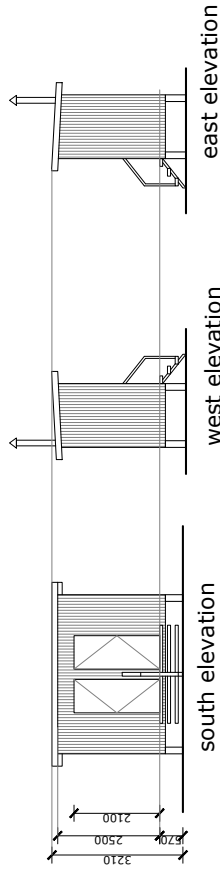

## Ground Floor Plan

ELECTRICAL LEGEND  
☐ S Selected ceiling mounted, self contained smoke detector  
 Hard wired to mains power. Complying with AS 3786

AS BUILT  
 AMENITIES BLOCK

Proposed Eco Resort & Primitive Camping  
 at 43 Synotts Lane, Ocean Shores

owner  
 -----

scale  
 1 : 1000  
 @ A3

date  
 Sept 2020

Drawn : David Robinson  
 10/100/2020/001/001  
 Byron Bay, 2481  
 ph : 0419 880048  
 email : ddivrobinson@gmail.com



Issue A



Drawn : David Robinson  
By : David Robinson  
Byron Bay, 2487  
ph : 0419 880048  
email : dirobinson@gmail.com

Issue A

date  
Sept 2020  
North

scale  
1 : 1250  
@ A3

owner  
-----

Proposed Eco Resort & Primitive Camping  
at 43 Synotts Lane, Ocean Shores

EXISTING CONDITIONS  
SITE SURVEY by Cantys