




BUILDINGS LEGEND

- WS WORKSHOP
- A1 AMENITIES 1
- A2 AMENITIES 2 (relocate)
- wt WATER TANKS
- 6.0 x 2.5 PARKING SPACE
- 3000 with 3.0m DRIVE
- RECREATIONAL AREAS
- PRIMITIVE CAMPING
- CAMPING AREAS 1-10
- B.D.A.R. AREA
- ZONED RU2



PROPOSED LAYOUT
SITE PLAN

at 43 Synotts Lane, Ocean Shores
Proposed Primitive Camping

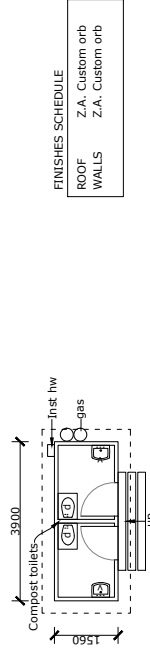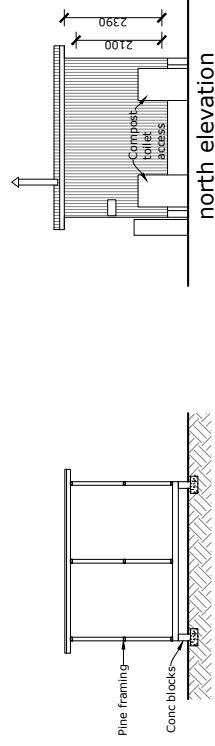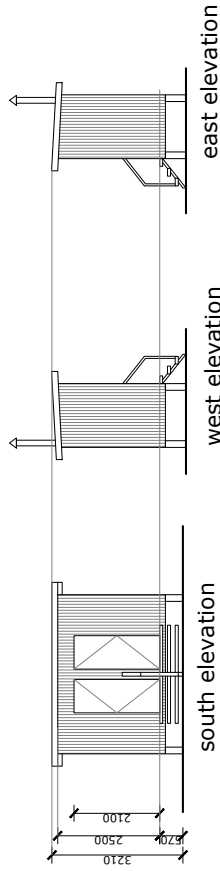

Ground Floor Plan

ELECTRICAL LEGEND
☐ S Selected ceiling mounted, self contained smoke detector
 Hard wired to mains power. Complying with AS 3786

AS BUILT
AMENITIES BLOCK

Proposed Eco Resort & Primitive Camping
at 43 Synotts Lane, Ocean Shores

owner

scale
1 : 1000
@ A3

date
Sept 2020

Drawn : David Robinson
 Checked : David Robinson
 By : David Robinson
 ph : 0419 880048
 email : dirobinson@gmail.com



Issue A