
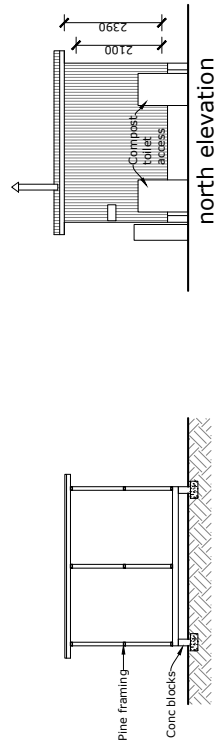


Received 04/07/24

BYRON SHIRE COUNCIL
Modification to development consent
APPROVED PLAN
Modified DA No. 10.2021.116.4
Date: 25/07/24

BYRON SHIRE COUNCIL
Modification to development consent
APPROVED PLAN
Modified DA No. 10.2021.116.4
Date: 25/07/24

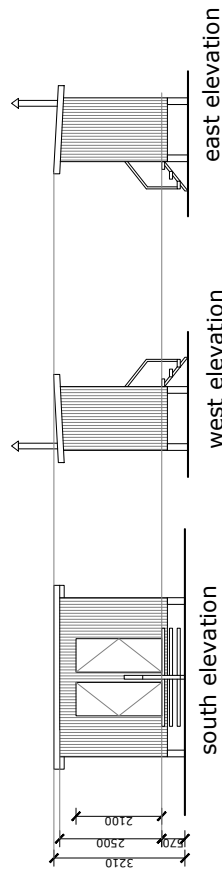

Ground Floor Plan

ELECTRICAL LEGEND
☐ S Selected ceiling mounted, self contained smoke detector
 Hard wired to mains power. Complying with AS 3786

FINISHES SCHEDULE

ROOF	Z.A. Custom orb
WALLS	Z.A. Custom orb

AS BUILT
AMENITIES BLOCK

Proposed Eco Resort & Primitive Camping
 at 43 Synotts Lane, Ocean Shores

owner

scale
 1 : 1000
 @ A3

date
 Sept 2020

Drawn : David Robinson
 Checked : David Robinson
 Byron Bay, 2481
 ph : 0419 880048
 email : dvrobinson@gmail.com



Issue A

3
 11

Received 04/07/24