BYRON SHIRE COUNCIL
Modification to development consent
APPROVED PLAN
Modified DA No. 10.2021.116.2
Date: 04/11/22

PROPOSED LAYOUT
SITE PLAN

Proposed Primitive Camping
at 43 Synotts Lane, Ocean Shores

owner
---

scale
1 : 1000
@ A3

date
Feb 2021

128 Old Bangalow Rd
Byron Bay , 2481
ph : 0419 880048
email : divrobinson@gmail.com

NORTH

Issue B

2/8

Received 13/09/22

BYRON SHIRE COUNCIL
Modification to development consent
APPROVED PLAN
Modified DA No. 10.2021.116.2
Date: 04/11/22

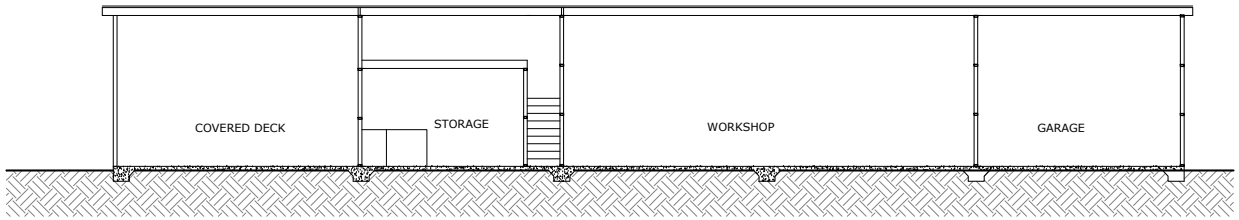

section A-A

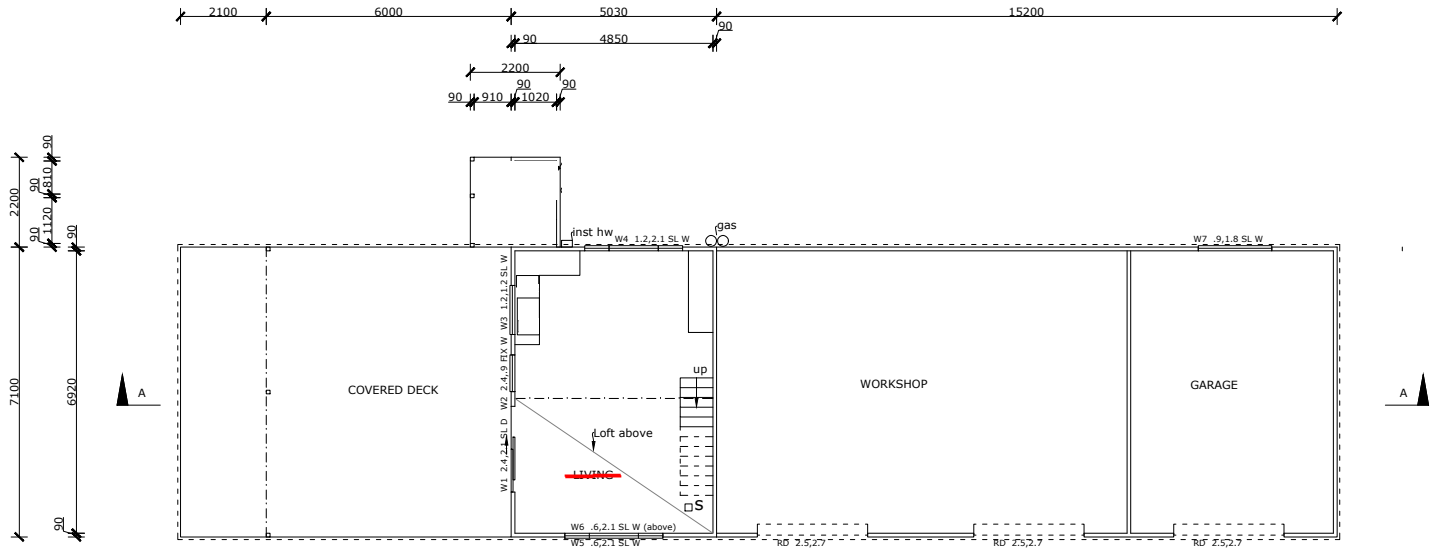

Floor Plan

ELECTRICAL LEGEND
S Selected ceiling mounted, self contained smoke detector
Hard wired to mains power. Complying with AS 3786

AS BUILT
WORKSHOP/ STORAGE SHED

Proposed Eco Resort & Primitive Camping
at 43 Synotts Lane, Ocean Shores

owner
---

scale
1 : 1000
@ A3

date
Sept 2020

Drawn : David Robinson
128 Old Bangalow Rd
Byron Bay , 2481
ph : 0419 880048
email : divrobinson@gmail.com

NORTH

Issue A