



NOTICE OF DETERMINATION OF A DEVELOPMENT APPLICATION

issued under the

Environmental Planning and Assessment Act, 1979 Section 4.18(1)(a)

Development Application No. 10.2019.338.1

Mr L A Le Sueur
28 Old Byron Bay Road
NEWRYBAR NSW 2479

Email: lyle@cedarcreekconstructions.com.au

Property description:	LOT: 8 DP: 1247689 1 Paddys Court BANGALOW
Development	Relocated Dwelling House
Determination	Consent granted subject to the attached schedule of conditions
Date determined:	14 August 2019
Consent to operate from:	19 August 2019
Consent to lapse on:	19 August 2024
Concurrent approvals:	Roads Act (51); Water & Sewer (60)

IMPORTANT INFORMATION

It is the responsibility of the applicant, landowner, builder, and any other contractors or agents involved with the development to read and understand all conditions of consent prior to commencing work.

The Environmental Planning and Assessment Act 1979 require you to:

1. Obtain a **Construction Certificate** prior to the commencement of any **building works** as required by conditions of this consent. An application may be lodged with Council, or you may apply to a private accredited certifier for a Construction Certificate. An accredited certifier **must obtain Council's approval** to certain conditions of this development consent, where indicated before issuing the Construction Certificate. Additional fees are payable for this application.
2. Nominate a **Principal Certifying Authority (PCA)** which may be either Council or an accredited certifier and notify Council of that appointment. You **cannot lawfully** commence works without complying with this requirement.
3. Give Council at least two days notice of your intention to commence the erection of a building **before** commencing construction works. You cannot lawfully commence works without complying with this requirement.
4. Obtain an **Occupation Certificate** before commencing occupation or commencing to use the building or on the completion of other works including the erection of a sign. You cannot lawfully commence occupation or the use of a building without complying with this requirement.

CONDITIONS OF CONSENT:

SCHEDULE 1 CONDITIONS OF CONSENT

Parameters of consent

1. Development is to be in accordance with approved plans

The development is to be in accordance with plans listed below:

Plan No.	Description	Dated:
01	Site Plans & Notes	27/4/2019
02	Ground Floor Plan	27/4/2019
03	Roof Plan	27/4/2019
04	Elevations	27/4/2019
05	Sections	27/4/2019
06	Water / Stormwater / Sewer	27/4/2019

The development is also to be in accordance with any changes shown in red ink on the approved plans or conditions of consent.

The approved plans and related documents endorsed with the Council stamp and authorised signature must be kept on site at all times while work is being undertaken.

2. Support for neighbouring buildings

If an excavation extends below the level of the base of the footings of a building on an adjoining allotment of land, the person causing the excavation to be made or builder must:

- Inform the neighbouring property owner immediately.
- Engage a structural engineer to determine any remedial works that may need to be undertaken.
- Preserve and protect the adjoining building from damage.
- If necessary, underpin and support the building in an approved manner.

The following conditions are to be complied with prior to issue of a Construction Certificate for building works

3. Compliance required with Building Over Pipelines Policy

All developments must comply with Policy 4.20. Swimming pools are classed as buildings and are required to comply with this policy.

Any brick / masonry fence crossing a pipeline requires Council approval. The fence must be supported such that it does not cause loading on the pipes zone-of-influence.

The use of displacement and screw pile construction methods will require approval by Council.

4. Water and Sewerage - Section 68 approval required

An **Approval** under Section 68 of the Local Government Act 1993 to carry out water supply work and sewerage work must be obtained.

5. Long Service Levy to be paid

In accordance with Section 4.68 of the Environmental Planning and Assessment Act 1979 (as amended), a Construction Certificate for SUBDIVISION WORKS OR BUILDING WORKS shall NOT be issued until any Long Service Levy payable under Section 34 of the Building and Construction Industry Long Service Payments Act, 1986 (or where such levy is payable by instalments, the first instalment of the levy) has been paid (as applicable).

These payments can be made online at www.longservice.nsw.gov.au. Proof of payment is required to be submitted with the Construction Certificate application.

For further information regarding the Long Service Payment please refer to the website above.

6. Site Waste Minimisation and Management

All works must comply with the objectives of waste minimisation and waste management of Part B8.1.2 of DCP 2014.

7. Tree Removal

No trees or vegetation to be cleared or removed until a Construction Certificate has been issued.

8. Sediment and Erosion Control Management Plan required

The application for a Construction Certificate is to include plans and specifications that indicate the measures to be employed to control erosion and loss of sediment from the site. Control over discharge of stormwater and containment of run-off and pollutants leaving the site/premises must be undertaken through the installation of erosion control devices such as catch drains, energy dissipaters, level spreaders and sediment control devices such as filter fences and sedimentation basins.

Such plans and specifications must be approved as part of the Construction Certificate.

NOTE: The plans must be in compliance with Council's current "Northern Rivers Local Government Development Design & Construction Manuals and Standard Drawings".

9. On-site stormwater detention required

The application for a Construction Certificate is to include plans and specifications for stormwater drainage in accordance with the relevant Australian Standard. All stormwater drainage for the development must be conveyed via an on-site stormwater detention system by gravity to kerb and gutter at the street frontage via a kerb adaptor.

Such plans and specifications must be approved as part of the Construction Certificate.

All stormwater drainage systems within the lot and the connection to a public or an inter-allotment drainage system must:

- (a) The detailed design of the stormwater management plan including the provision of OSD must be prepared and certified by a suitably qualified engineer.
- (b) comply with any requirements for the disposal of stormwater drainage and on-site stormwater detention contained in Council's Development Control Plan, Stormwater Guideline and Local Approvals Policy; and
- (c) unless exempt from obtaining an approval under section 68 of the Local Government Act 1993 by a Local Approvals Policy, an approval must be obtained under that Act prior to issue of a Construction Certificate.

10. Consent required for works within the road reserve

Consent from Council must be obtained for works within the road reserve pursuant to Section 138 of the Roads Act 1993. Three (3) copies of engineering construction plans must accompany the application for consent for works within the road reserve.

Such plans are to be in accordance with Council's current Design & Construction Manuals and are to provide for the following works:

Driveway (residential areas) A driveway(s) in accordance with Council's current "Northern Rivers Local Government Development Design & Construction Manuals and Standard Drawings".

11. Access & Parking

The application for a Construction Certificate is to include plans and specification that indicate access, parking and manoeuvring details in accordance with the plans approved by

this consent.

The access, parking and manoeuvring for the site is to comply with the requirements of AS 2890.1-2004: Parking facilities, Part 1: Off-street car parking and AS 2890.2 – 2010 - Parking facilities. Plans are to include, but not be limited to, the following items:

- a) pavement design, comprising an all weather surface, such as asphalt, bitumen seal, concrete, pavers or other similar treatment;
- b) site conditions affecting the access;
- c) existing and design levels; and
- d) longitudinal section from the road centreline to the car space(s).

Such plans and specifications must be approved as part of the Construction Certificate.

NOTE: The plans must be in compliance with Council's current "Northern Rivers Local Government Development Design & Construction Manuals and Standard Drawings".

12. Flood Planning Level

The flood planning level for this development is R.L.44.15m A.H.D. The plans and specifications to accompany the construction certificate application are to indicate the use of flood compatible materials and services below the flood planning level in accordance with the requirements of Council's Development Control Plan 2014 – Chapter C2 – Areas Affected by Flood.

13. Bond required to guarantee against damage to public land

A bond of \$3,000 is to be paid to Council as guarantee against damage to surrounding public land and infrastructure during construction of the proposed development. Evidence is to be provided to Council indicating the pre development condition of the surrounding public land and infrastructure. Such evidence must include photographs. The proponent will be held responsible for the repair of any damage to roads, kerb and gutters, footpaths, driveway crossovers or other assets.

Such bond will be held until Council is satisfied that the infrastructure is maintained/repaired to pre development conditions and that no further work is to be carried out that may result in damage to Council's roads, footpaths etc.

14. Public liability insurance cover required

The developer and/or contractor must produce evidence to the Principal Certifying Authority of public liability insurance cover for a minimum of \$20 million. Council is to be nominated as an interested party on the policy.

The following conditions are to be complied with prior to any building or construction works commencing

15. Erosion and sediment measures

Erosion and sedimentation controls are to be in place in accordance with the approved Erosion and Sediment Control Plan.

Sediment and erosion control measures in accordance with the approved Erosion and Sedimentation Control plan/s must be maintained at all times until the site has been stabilised by permanent vegetation cover or hard surface.

Any such measures that are deemed to be necessary because of the local conditions must be maintained at all times until the site is made stable (i.e. by permanent vegetation cover or hard surface).

Note: Council may impose on-the-spot fines for non-compliance with this condition.

16. Toilet facilities

Toilet facilities are to be provided, at or in the vicinity of the work site at the rate of one toilet for every 20 persons or part of 20 persons employed at the site. Each toilet provided must be a toilet connected to an accredited sewage management system approved by the Council.

17. Water service to be connected

A water service must be connected to the property using an approved backflow prevention device. It is the applicant's responsibility to engage a licensed plumber who shall liaise with council during this process.

Any new water service will be at the applicants cost.

The following conditions are to be complied with during any building or construction works

18. Construction times

Construction works must not unreasonably interfere with the amenity of the neighbourhood. In particular construction noise, when audible from adjoining residential premises, can only occur:

- a. Monday to Friday, from 7 am to 6 pm.
- b. Saturday, from 8 am to 1 pm.

No construction work to take place on Saturdays and Sundays adjacent to Public Holidays and Public Holidays and the Construction Industry Awarded Rostered Days Off (RDO) adjacent to Public Holidays.

Note: Council may impose on-the-spot fines for non-compliance with this condition.

19. Construction Noise

Construction noise is to be limited as follows:

- a. For construction periods of four (4) weeks and under, the L10 noise level measured over a period of not less than fifteen (15) minutes when the construction site is in operation must not exceed the background level by more than 20 dB(A).
- b. For construction periods greater than four (4) weeks and not exceeding twenty-six (26) weeks, the L10 noise level measured over a period of not less than fifteen (15) minutes when the construction site is in operation must not exceed the background level by more than 10 dB(A)

Note: Council may impose on-the-spot fines for non-compliance with this condition.

20. Signs to be erected on building and demolition sites

A sign must be erected in a prominent position on the work site:

- a. stating that unauthorised entry to the work site is prohibited, and
- b. showing the name of the person in charge of the work site and a telephone number at which that person may be contacted outside working hours.

Any such sign is to be removed when the work has been completed.

21. Builders rubbish to be contained on site

All builders rubbish is to be contained on the site in a 'Builders Skips' or an enclosure. Footpaths, road reserves and public reserves are to be maintained clear of rubbish, building materials and all other items.

22. Fill to be retained on the subject land

Fill material must not encroach onto any adjoining land.

23. Prevention of water pollution

Only clean and unpolluted water is to be discharged to Council's stormwater drainage system or any watercourse to ensure compliance with the Protection of Environment Operations Act.

Note: Council may impose on-the-spot fines for non-compliance with this condition.

24. Removal of asbestos

All asbestos wastes associated with removal of the existing dwelling to be disposed of in accordance with the requirements of the Workcover Authority. The applicant/owner is to produce documentary evidence that this condition has been met.

Please note the Byron Resource Recovery Centre can not accept asbestos. You will need to arrange disposal at an alternate landfill site.

25. Maintenance of sediment and erosion control measures

Sediment and erosion control measures must be maintained at all times until the site has been stabilised by permanent vegetation cover or hard surface.

26. Stormwater drainage work

Stormwater drainage for the development must be constructed in accordance with the approved plans and specification by a suitably qualified person.

27. Demolition

Any required demolition works must be undertaken in accordance with the relevant requirements of Australian Standard AS 2601–1991: The Demolition of Structures published by Standards Australia, and the WorkCover Authority of NSW.

28. Removal of demolition and other wastes

All wastes, including asbestos and lead-contaminated wastes, associated with these works are to be handled and disposed of in accordance with the requirements of the Work Cover Authority. The applicant/owner is to produce documentary evidence that this condition has been met. Wastes must be disposed of at a Licenced Waste Facility. All wastes removed from the site must be managed and disposed of in accordance with the NSW DECC Waste Classification Guidelines (2008)

www.environment.nsw.gov.au/resources/waste/08202classifyingwaste.pdf

The following conditions are to be complied with prior to occupation of the building

29. Works to be completed prior to issue of a Final Occupation Certificate

All of the works indicated on the plans and approved by this consent, including any other consents that are necessary for the completion of this development, are to be completed and approved by the relevant consent authority/s prior to the issue of a Final Occupation Certificate.

Any Security bond paid for this application will be held until Council is satisfied that no further works are to be carried out that may result in damage to Councils road/footpath reserve.

30. Stormwater disposal

Stormwater must be collected and disposed of in a controlled manner such that stormwater flows are:

- a. Clear of buildings and infrastructure,
- c. Not concentrated so as to cause soil erosion,
- d. Not directly to a watercourse, and
- e. Not onto adjoining land.

31. **Access to be completed.**
The access to the site is to be constructed in accordance with the approved plans and Roads Act consent.
32. **Internal driveway in accordance approved plans**
A driveway is to be constructed from the property boundary to the proposed car space(s) in accordance with the approved plans.
33. **Floor Levels – Certification for Flooding**
Prior to the issue of an Occupation Certificate, a certificate from a registered surveyor must be submitted to the Principal Certifying Authority confirming the height of habitable and non-habitable floors. An Occupation Certificate must not be issued unless the floor levels are at or above the relevant flood planning levels.
34. **On-site Stormwater Detention – Certification of works**
All stormwater drainage works, including on-site stormwater detention works, for the development must be constructed in accordance with the approved plans and specification prior to issue of an occupation certificate. Certificate/s of Compliance and Work-As-Executed (WAE) plans for the stormwater works must be submitted to the Principal Certifying Authority prior to the issue of an occupation certificate.
The certificate/s and WAE plans are to be prepared by a suitably qualified engineer and must be in accordance with Council's [Comprehensive Guidelines for Stormwater Management](#).

The following conditions are to be complied with at all times

35. **Approved use**
Dwelling house – Use of the development is approved for a dwelling house. Any activity other than that defined as dwelling house must not be carried out unless development consent is sought.
(Note. **dwelling house** means “a building containing only one dwelling”, and **dwelling** means “a room or suite of rooms occupied or used or so constructed or adapted as to be capable of being occupied or used as a separate domicile”. The dwelling house is not approved as Short term rental accommodation, tourist and visitor accommodation or to be “holiday let”.

SCHEDULE 2 PRESCRIBED CONDITIONS

The prescribed conditions in accordance with Division 8A of the Environmental Planning and Assessment Regulation apply as are of relevance to this application:

- Clause 98 Compliance with Building Code of Australia and insurance requirements under the Home Building Act 1989
- Clause 98A Erection of signs
- Clause 98B Notification of Home Building Act 1989 requirements
- Clause 98E Condition relating to shoring and adequacy of adjoining property

Refer to the NSW State legislation for full text of the clauses under Division 8A of the [Environmental Planning and Assessment Regulation 2000](#). This can be accessed at <http://www.legislation.nsw.gov.au>.

Construction Certificate required:

This development consent is issued under the Environmental Planning and Assessment Act 1979 and does not relate to structural aspects or specifications of the building under the Building Code of Australia. All buildings and alterations require the issue of a Construction Certificate prior to works commencing. Application forms are available from the customer services counter or Council's website www.byron.nsw.gov.au

Principal Certifying Authority:

Work must not commence until the applicant has:-

- a. appointed a Principal Certifying Authority (if the Council is not the PCA); and
- b. given Council at least two days notice of the intention to commence the erection of the building. Notice must be given by using the prescribed 'Form 7'.
- c. notified the Principal Certifying Authority of the Compliance with Part 6 of the Home Building Act 1989.

Occupation Certificate required:

The building must not be occupied until the Principal Certifying Authority has issued an Occupation Certificate.

Protection of the Environment Operations Act 1997:

It is an offence under the provisions of the Protection of the Environment Operations Act 1997 to act in a manner causing, or likely to cause, harm to the environment. Anyone allowing material to enter a waterway or leaving material where it can be washed off-site may be subject to a penalty infringement notice ("on-the-spot fine") or prosecution.

Penalties apply for failure to comply with development consents

Failure to comply with conditions of development consent may lead to an on the spot fine being issued pursuant to section 4.2(1) of the Environmental Planning & Assessment Act 1979 or prosecution pursuant to section 9.50 of the Environmental Planning & Assessment Act 1979.

Plumbing Standards and requirements.

All Plumbing, Water Supply, Sewerage and Stormwater Works shall be installed in accordance with the Local Government Act 1993, Plumbers Code of Australia and AS/NZS 3500 Parts 0-5, the approved plans (any notations on those plans) and the approved specifications. Any plumbing inspections required under a Section 68 Approval are to occur in accordance with that approval.

Relics Provisions- Advice

Attention is directed to the NSW Heritage Act 1977 and the provisions of the Act in relation to the exposure of relics. The Act requires that if:

- a) a relic is suspected, or there are reasonable grounds to suspect a relic in ground, that is likely to be disturbed damaged or destroyed by excavation; and/or
- b) any relic is discovered in the course of excavation that will be disturbed, damaged or destroyed by further excavation;

Those responsible for the discovery must notify nominated management personnel who will in turn notify the Heritage Council of New South Wales or its delegate, the Office of Environment and Heritage, NSW Heritage Branch, and suspend work that might have the effect of disturbing, damaging or destroying such relic until the requirements of the NSW Heritage Council have been satisfied (ss139, 146).

Statement of Reasons

The proposed development complies with the provisions of Byron Local Environmental Plan 2014.
The proposed development complies with relevant State Environmental Planning Policies
The proposed development complies with relevant provisions of Development Control Plan 2014
The proposed development complies with Environmental Planning & Assessment Regulation 2000 considerations.
The proposed development will not have significant adverse impact on the natural, built or social environment or economic impacts on the locality.
The proposed development is considered suitable for the proposed site.
The proposed development is unlikely to prejudice or compromise the public interest.
The proposed development will not have a detrimental impact on the heritage character of the precinct or the buildings contained on the site. It is considered consistent with the heritage provisions contained within Clause 5.10 of Local Environmental Plan 2014.
The proposed development will not have a detrimental impact on the heritage character of the precinct or the buildings contained on the site. It is considered consistent with the heritage provisions contained within Development Control Plan 2014.

How community views were addressed

The DA did not require advertising or notification as per Development Control Plan 2014.

Reason for conditions

The conditions imposed have been included in response to development considerations and to ensure a high standard of development having regard to the effect upon the environment and the amenity of the neighborhood.

Dial Before You Dig

Underground assets may exist in the area that is subject to your application. In the interests of health and safety and in order to protect damage to third party assets please contact Dial before you dig at www.1100.com.au or telephone on 1100 before excavating or erecting structures (This is the law in NSW). If alterations are required to the configuration, size, form or design of the development upon contacting the Dial before You Dig service, an amendment to the development consent (or a new development application) may be necessary. Individuals owe asset owners a duty of care that must be observed when working in the vicinity of plant or assets. It is the individual's responsibility to anticipate and request the nominal location of plant or assets on the relevant property via contacting the Dial before you dig service in advance of any construction or planning activities.

Telecommunications Act 1997 (Commonwealth) Telstra (and its authorised contractors) are the only companies that are permitted to conduct works on Telstra's network and assets. Any person interfering with a facility or installation owned by Telstra is committing an offence under the Criminal Code Act 1995 (Cth) and is liable for prosecution.

Furthermore, damage to Telstra's infrastructure may result in interruption to the provision of essential services and significant costs. If you are aware of any works or proposed works which may affect or impact on Telstra's assets in any way, you are required to contact: Telstra's Network Integrity Team on Phone Number 1800810443.

Are you dissatisfied with conditions of consent?

If you are unhappy with conditions of consent discuss your concerns with the officer who dealt with your application. You may submit an application to Council to modify the consent under Section 4.55 of the Environmental Planning & Assessment Act, 1979.

You will need to provide reasons why the conditions should be changed or deleted. You may lodge a Section 4.55 application at any time after the notice of determination. If you are not happy with Council's decision on your request for modification, then you may appeal to the Land & Environment Court within six (6) months of the notification by Council.

Right of Review

You may request Council to review its decision under Section 8.2 of the Environmental Planning and Assessment Act, 1979. Such a request must be made within six (6) months of the date of the determination, or if there is an appeal to the Land and Environment Court, up to the time when the court hands down its decision. In reviewing its decision Council is able to consider alterations to the above plans, provided that the Development Application remains substantially the same as the one for which the consent was originally sought, and the changes are publicly notified.


NOTE: This clause does not relate to Integrated Development Applications, applications determined by the Joint Regional Planning Panel or applications previously considered under Section 8.2 of the Environmental Planning and Assessment Act 1979.

Right of Appeal

If you are dissatisfied with this decision, Section 8.7 of the *Environmental Planning and Assessment Act 1979* gives you the right to appeal to the Land and Environment Court within six (6) months after the date on which you receive this notice.

Signed on behalf of the Consent Authority

Yours faithfully

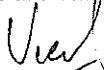

Mr J R Vickers
Planner

Dated: 19 August 2019

DRAWING LIST

ISSUE	No	NAME	SCALE
	01	SITE PLANS & NOTES	1:2000 / 1:200
	02	GROUND FLOOR PLAN	1:100
	03	ROOF PLAN	1:100
	04	ELEVATIONS	1:100
	05	SECTIONS	1:100

BASIX Nº


FLOOR SPACE RATIO AREAS

ZONE NAME	AREA	SITE AREA	FSR
PROPOSED RELOCATED DWELLING + ADDITION	152m2	657m2	23%

BYRON COUNCIL
DEVELOPMENT CONSENT
THIS IS THE PLAN ATTACHED TO
DEVELOPMENT CONSENT No: 10.2019. 338.1
DATED: 14/8/2019



LOCATION
Scale 1:2000

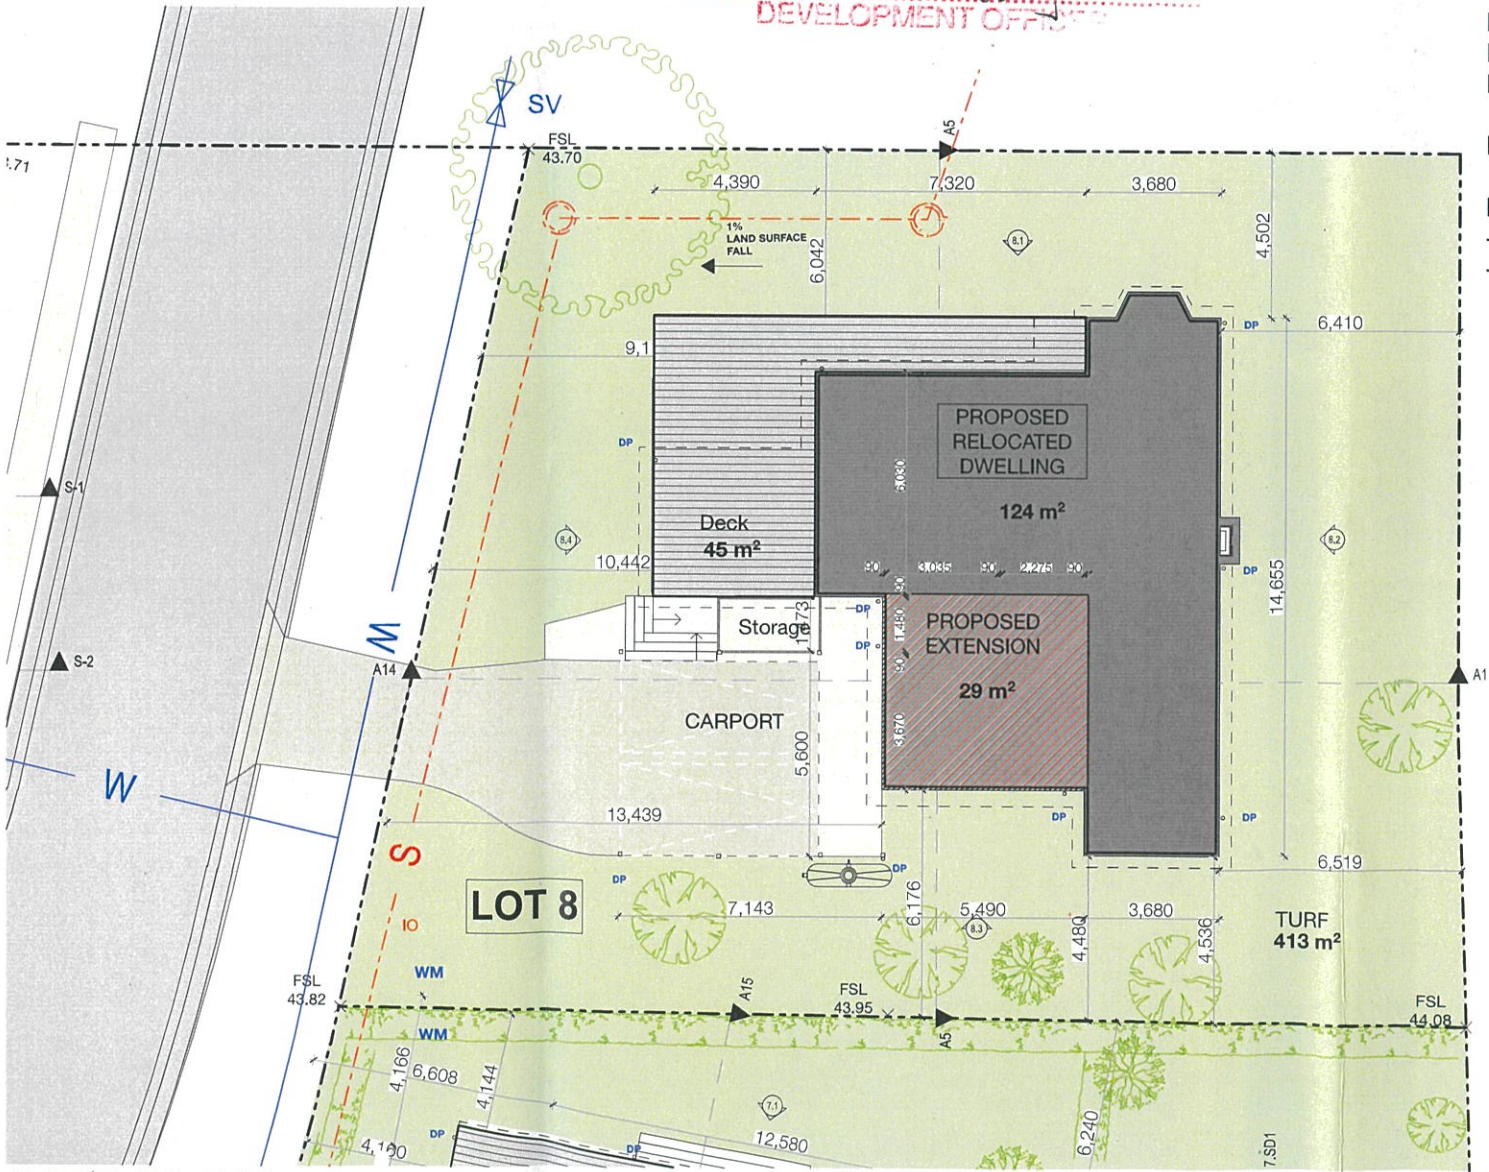

SITE PLAN
Scale 1:200

LANDSCAPE :
BUILDING FOOTPRINT : 176m²
DRIVEWAY/PATHS : 108m²

DECK AREAS : 45m²

LANDSCAPE AREAS : 413m² (62% of land size)
- TURF (sir walter buffalo) : 313m²
- PLANTING: 100m² (low water use natives)


KEY

DELETED EXISTING WALL

NEW WALL

Dx NEW EXTERNAL OPENING


IDx NEW INTERNAL OPENING

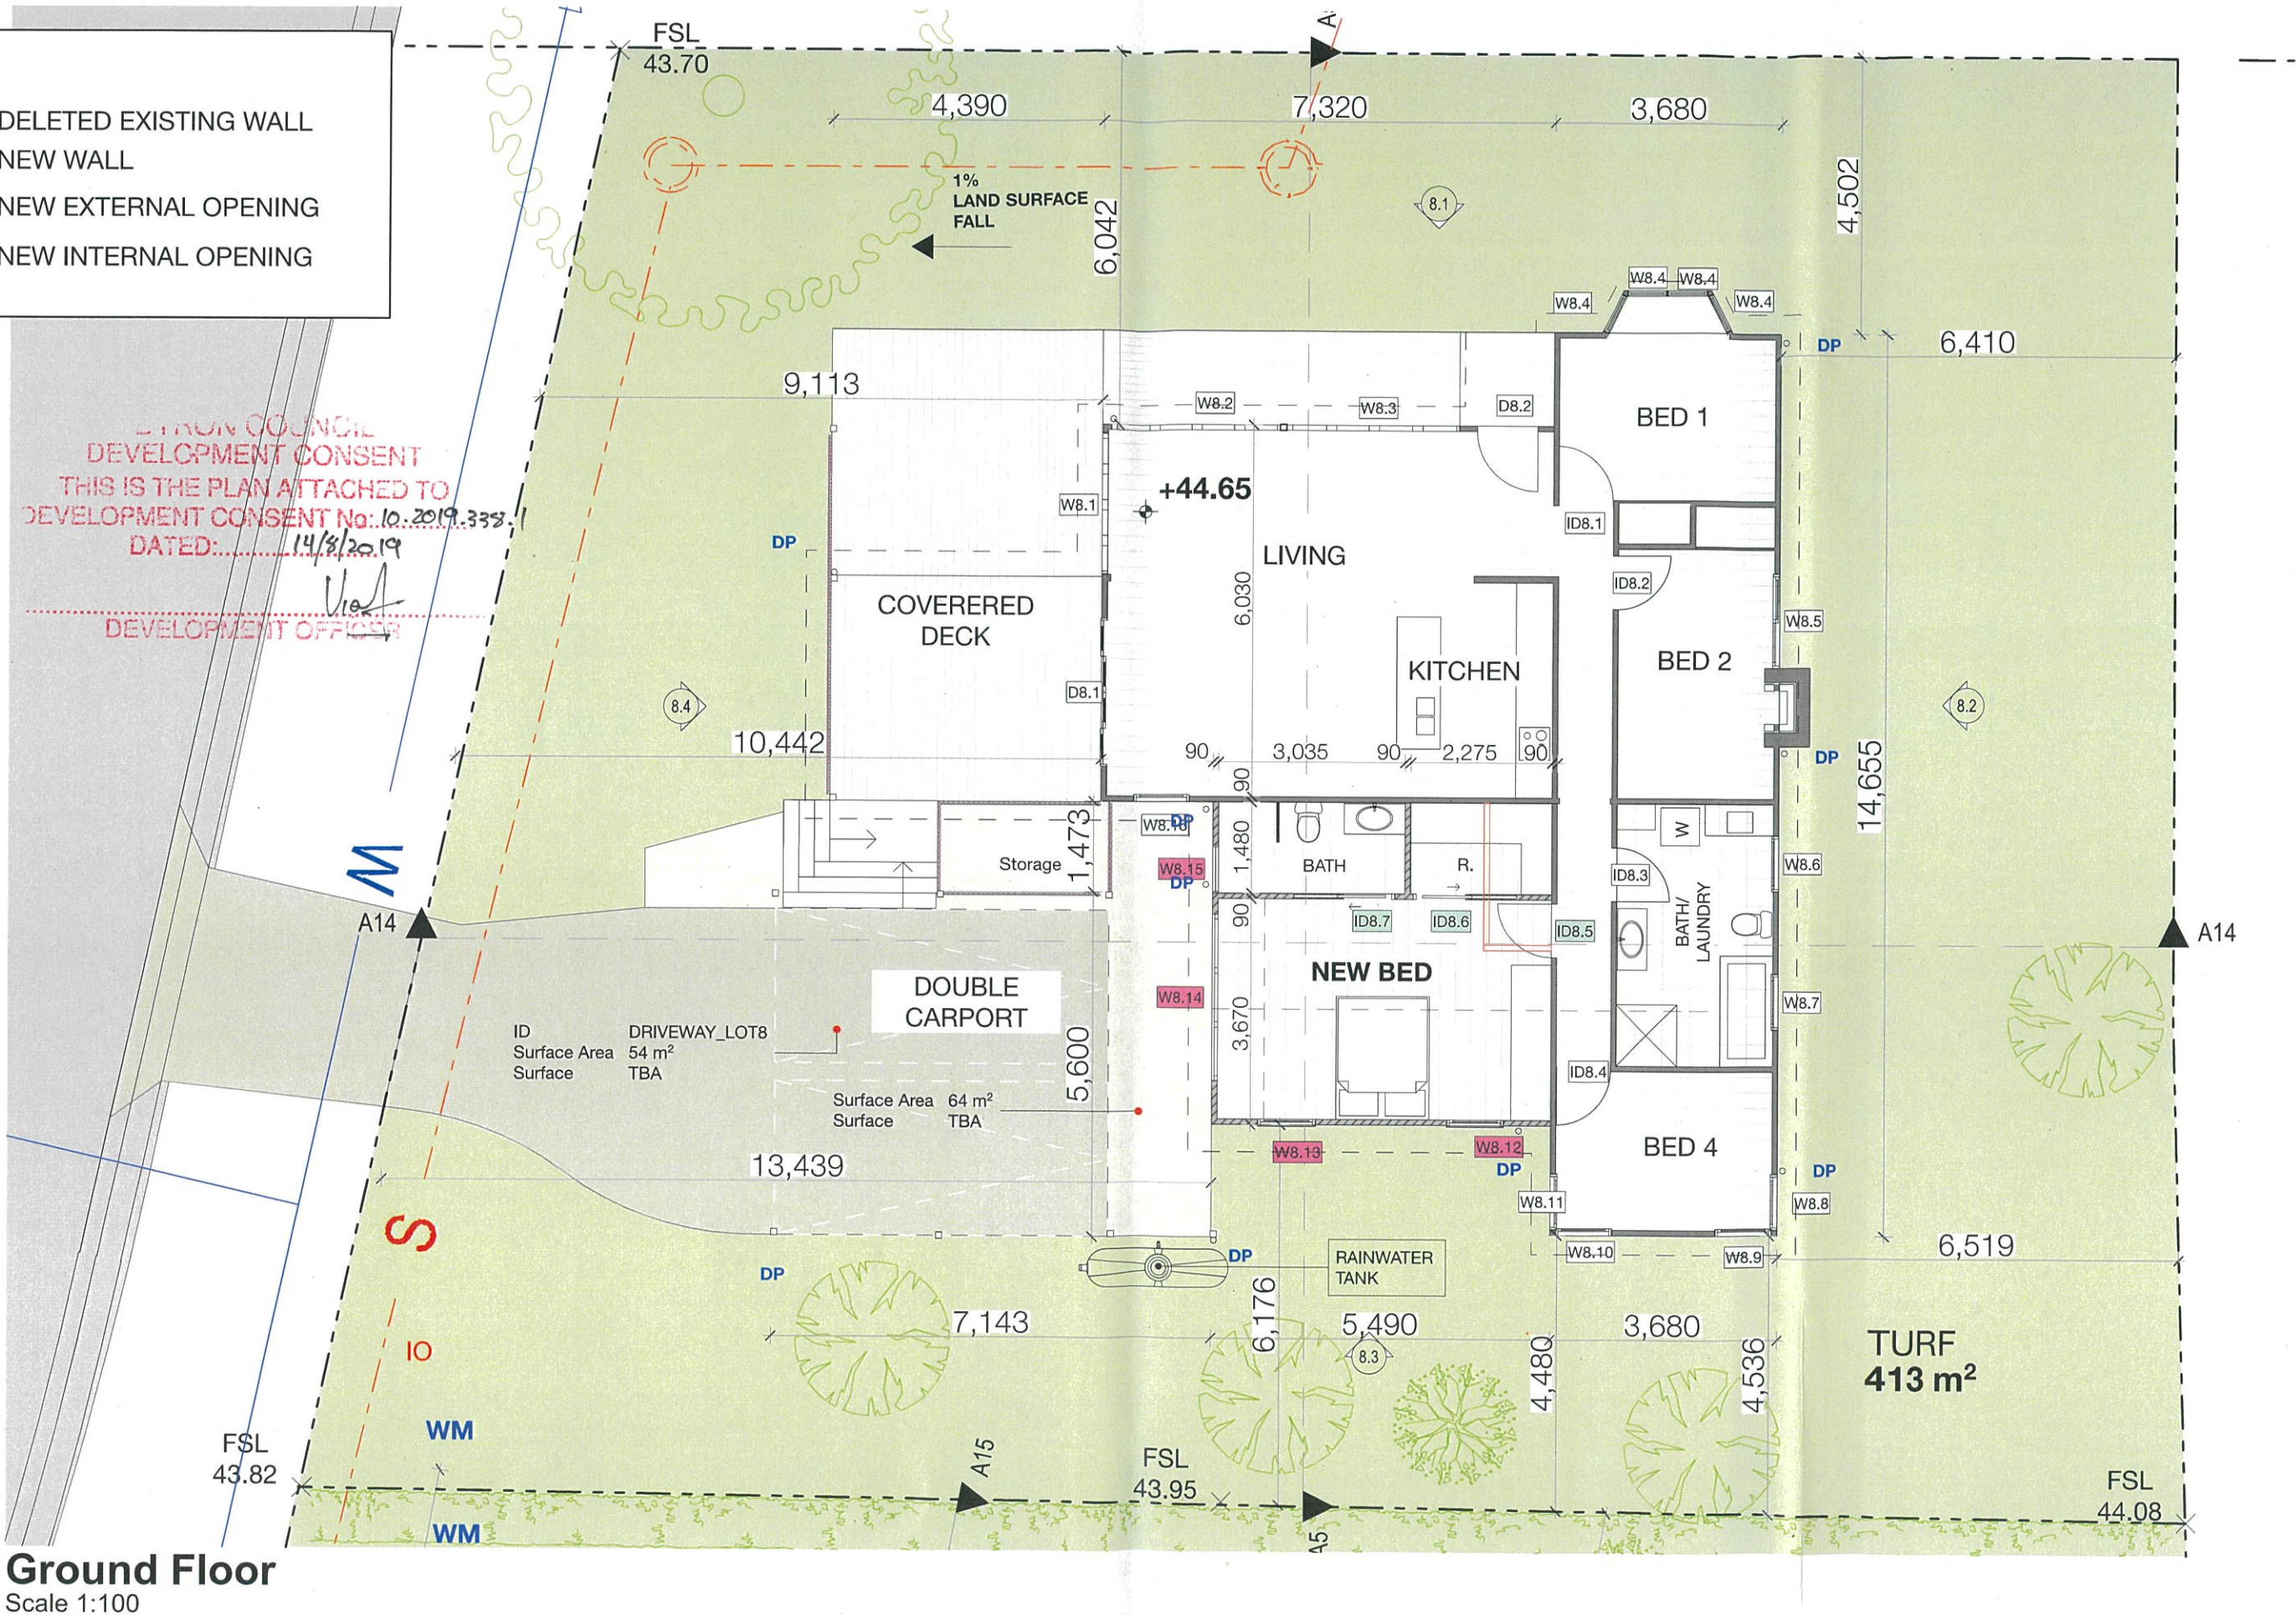

BYRON COUNCIL
DEVELOPMENT CONSENT
THIS IS THE PLAN ATTACHED TO
DEVELOPMENT CONSENT No: 10.2019.338.1
DATED: 14/8/2019
DEVELOPMENT OFFICER

SOLAR HWS
ELEC. BOOSTED

Roof plan
Scale 1:100

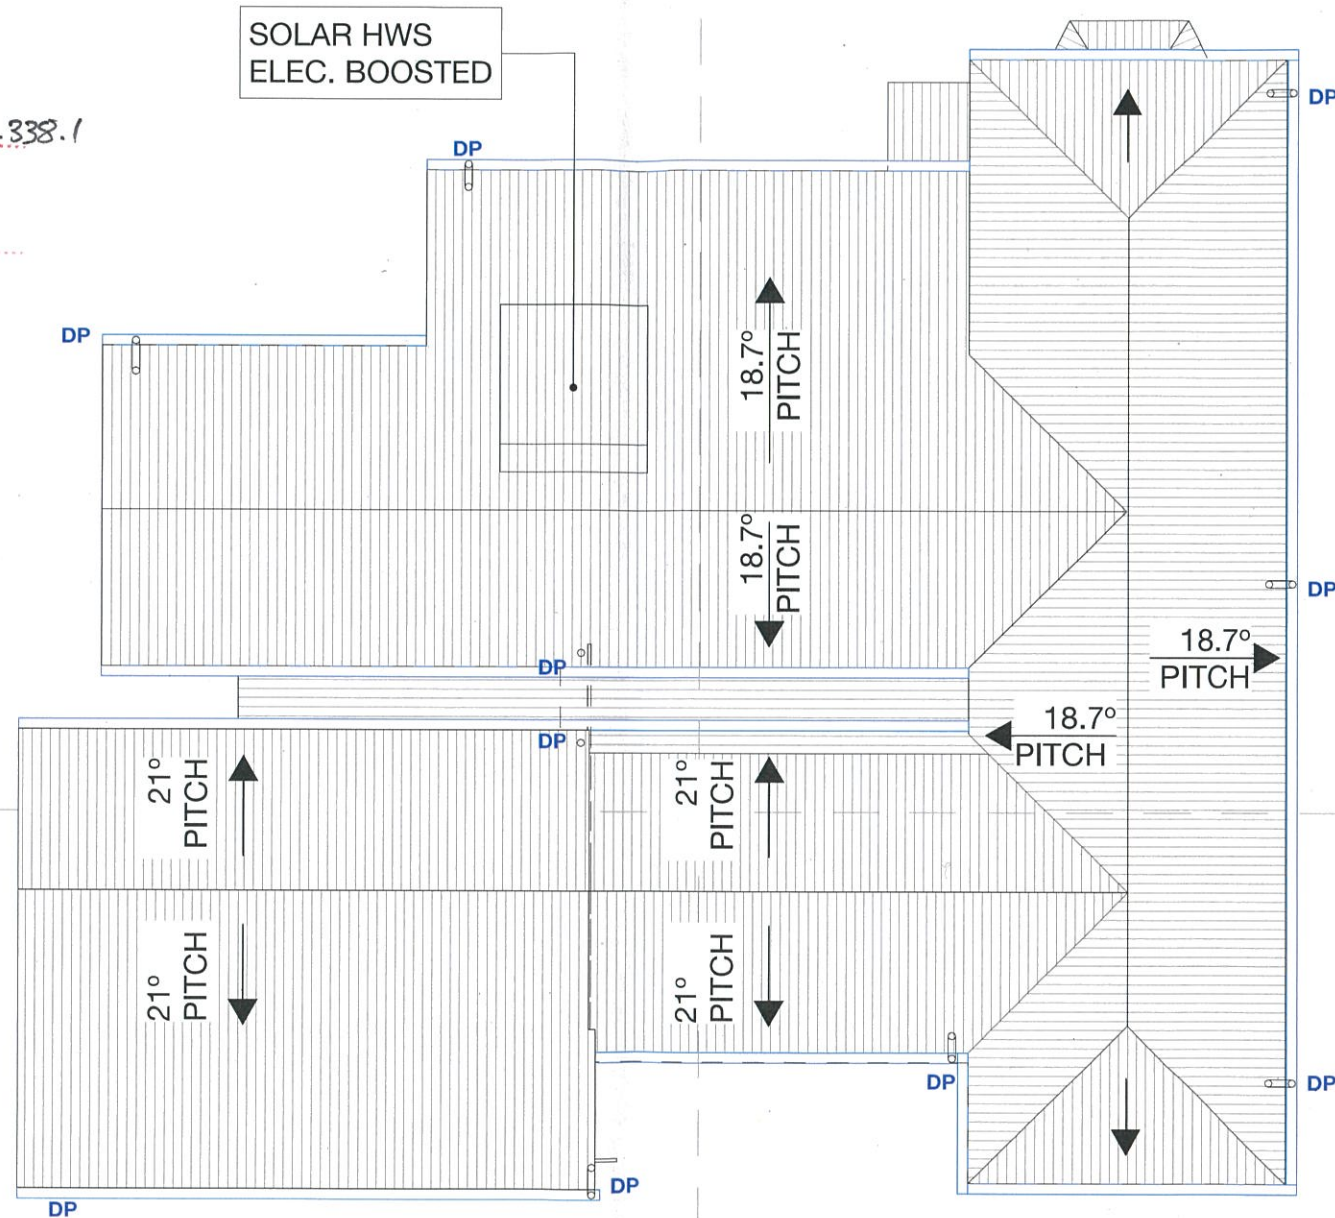


DEVELOPMENT APPLICATION
NOT FOR CONSTRUCTION

OWNER: LA + MC LESUEUR
ADDRESS:
PADDY'S COURT,
BANGALOW 2479
DP. 1247689

ROOF PLAN

ISSUE : DA	REVISION: A	DRAWING N°
DATE: 27/04/2019	PAPER SIZE : A3	03
ALL DIMENSIONS TO BE CHECKED ON SITE PRIOR TO CONSTRUCTION		

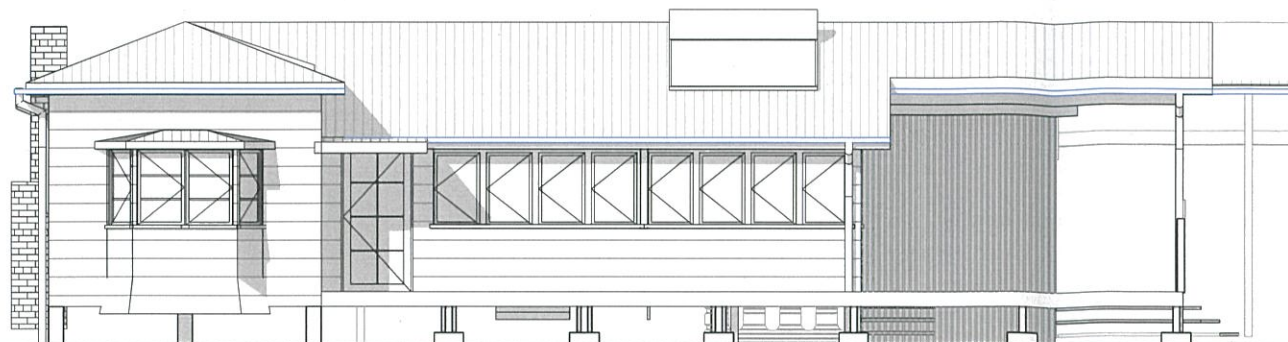

NORTH ELEVATION

Scale 1:100




EAST ELEVATION

Scale 1:100



SOUTH ELEVATION

Scale 1:100

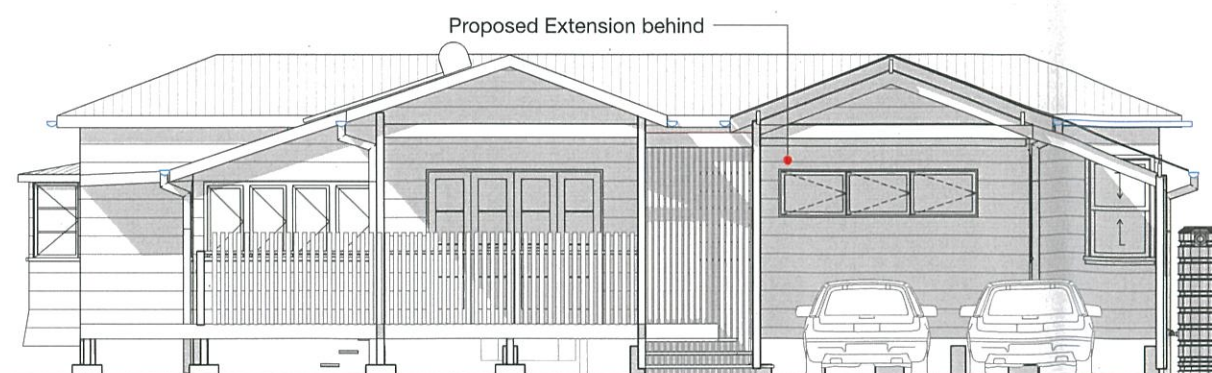



WEST ELEVATION

Scale 1:100

BYRON COUNCIL
DEVELOPMENT CONSENT
THIS IS THE PLAN ATTACHED TO
DEVELOPMENT CONSENT No: 10.2019.338.1
DATED: 14/8/2019
Vicki
DEVELOPMENT OFFICER

MATERIALS COLOUR PALETTE :


-  WB = Weatherboard
Colour = Cream
-  Cb = Colorbond
Colour = off white

DEVELOPMENT APPLICATION
NOT FOR CONSTRUCTION

OWNER: LA + MC LESUEUR
ADDRESS:
PADDY'S COURT,
BANGALOW 2479
DP: 1247689


ELEVATIONS

ISSUE : DA	REVISION: A	DRAWING N° 04
DATE: 27/04/2019	PAPER SIZE : A3	
ALL DIMENSIONS TO BE CHECKED ON SITE PRIOR TO CONSTRUCTION		

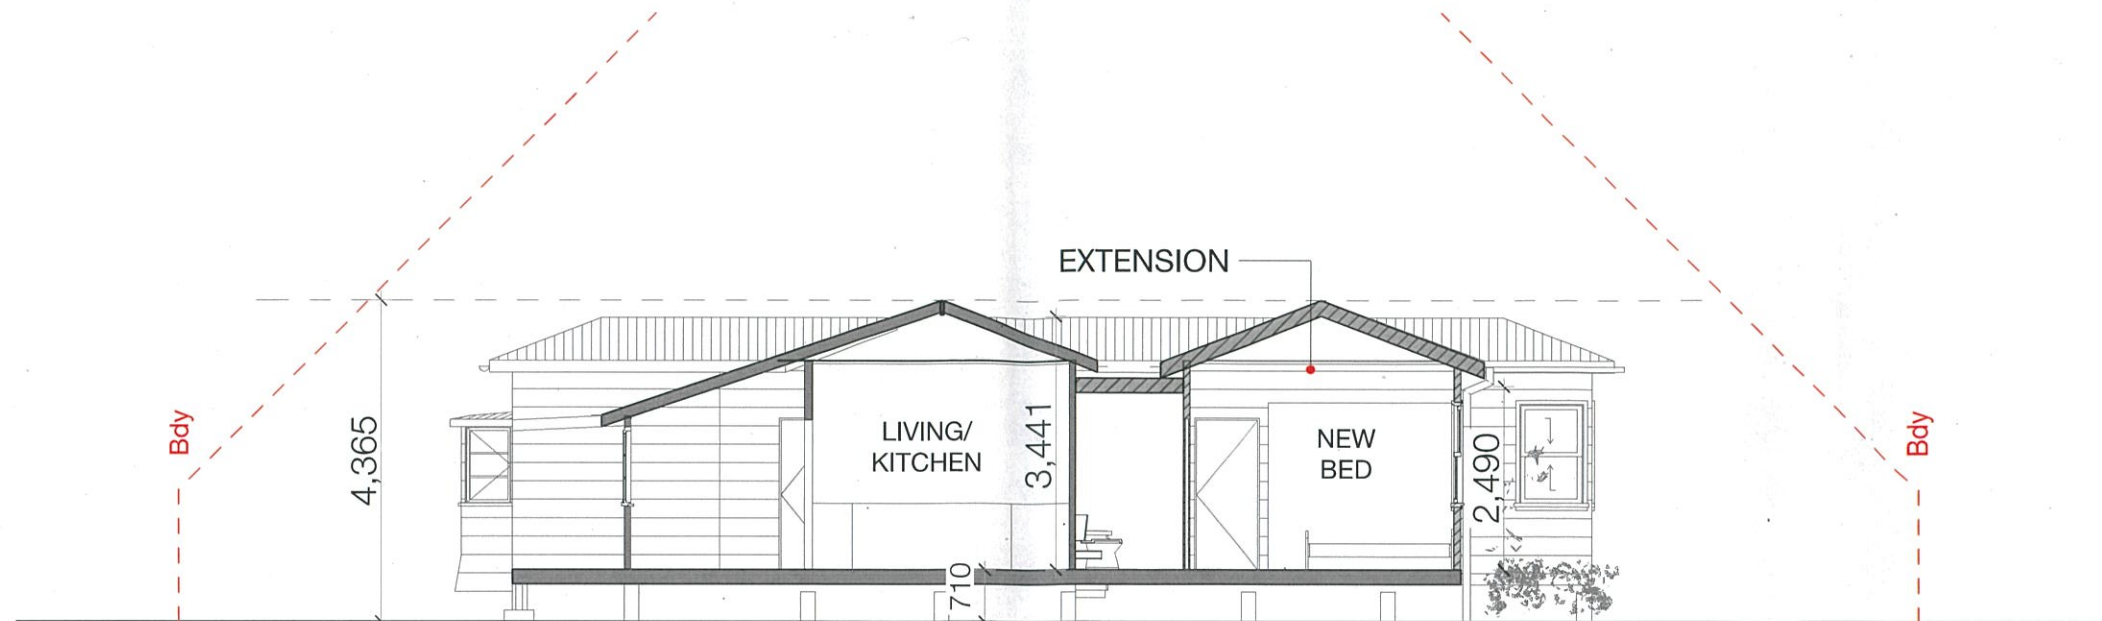


OP1 SEC
Scale 1:100

DEVELOPMENT CONSENT
THIS IS THE PLAN ATTACHED TO
DEVELOPMENT CONSENT No. 10.2019.338.1
DATED: 14/8/2019
Vic
DEVELOPMENT OFFICER

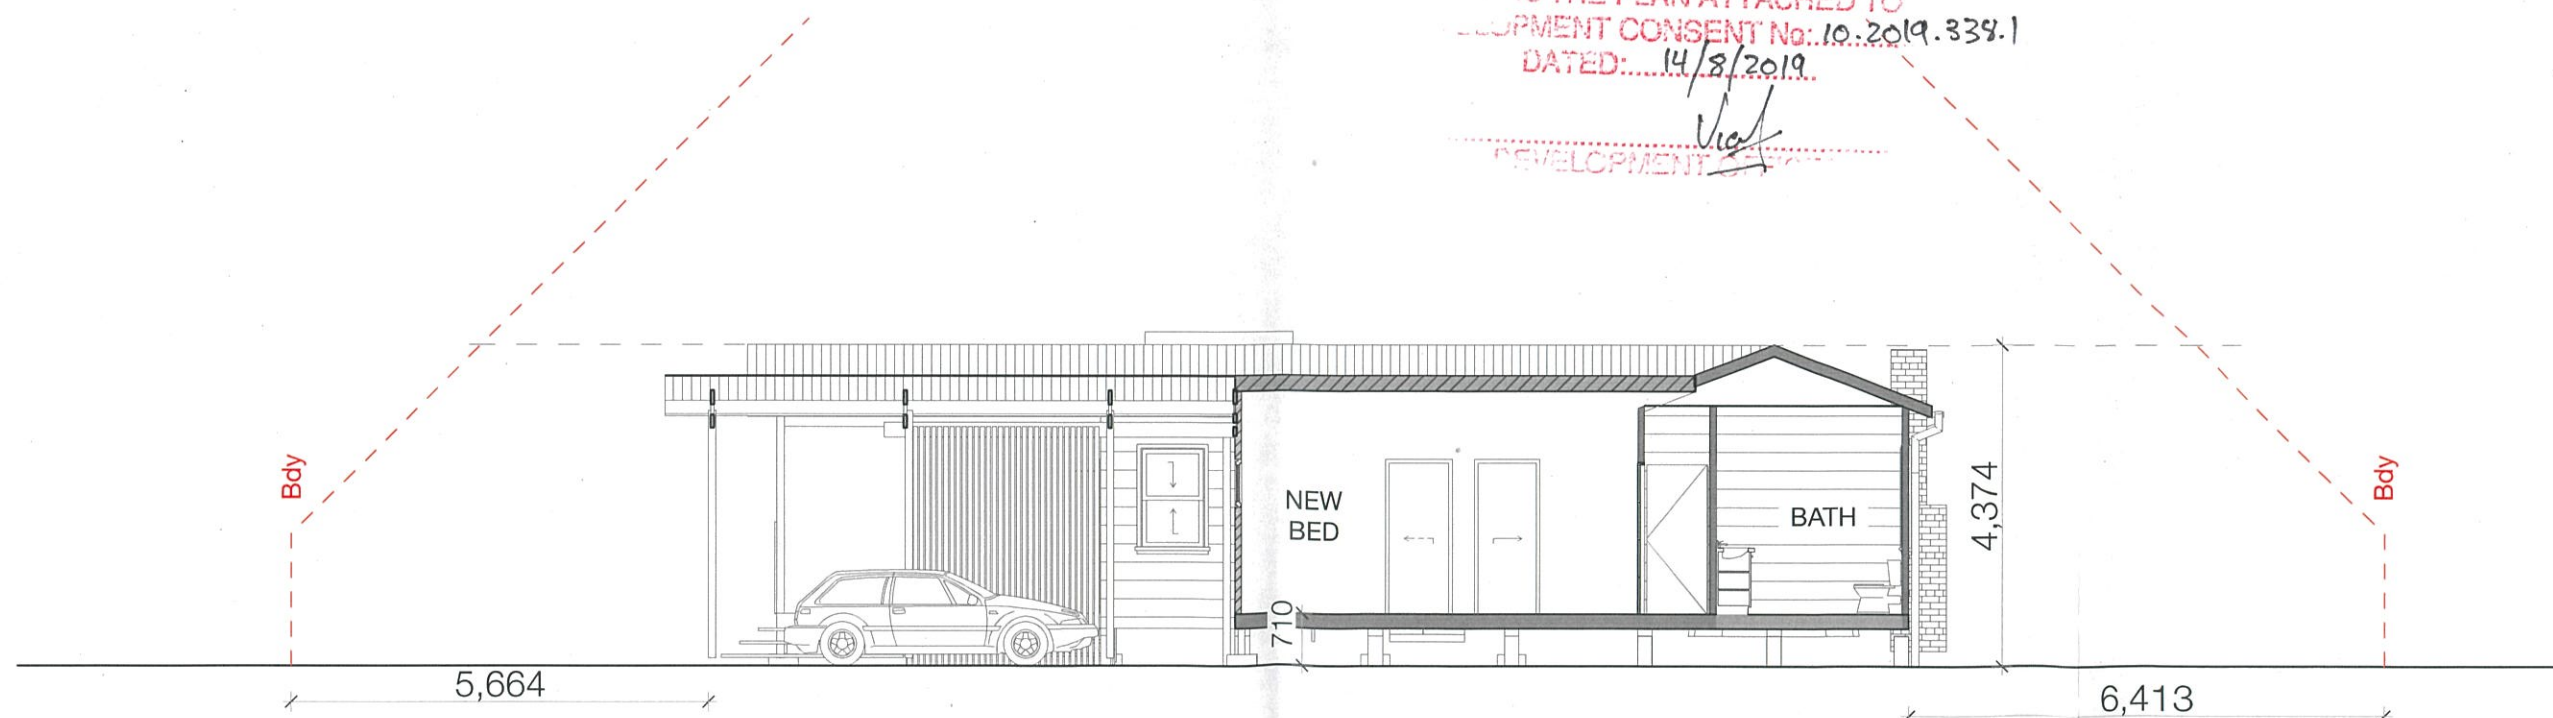

SECTION A
Scale 1:100

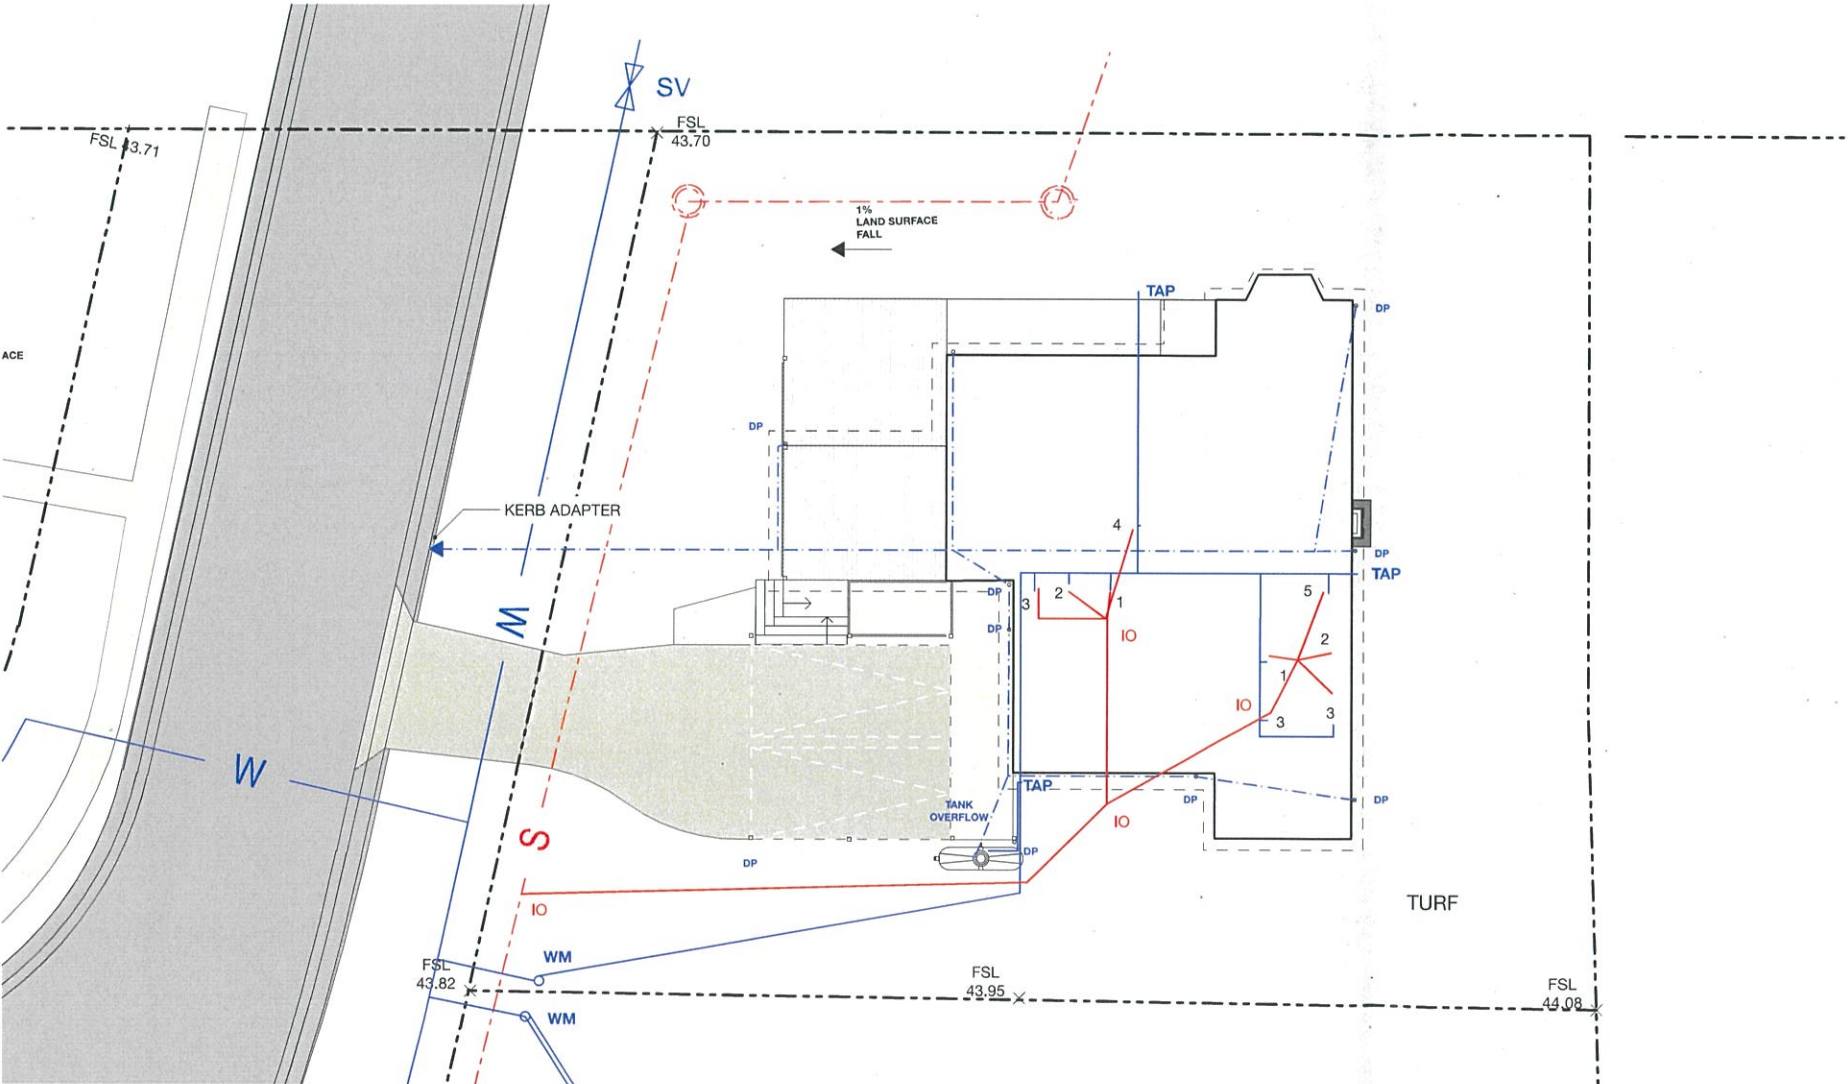

WATER/STORMWATER/SEWER
Scale 1:200

REFERENCE

- 1. BASIN
- 2. WC
- 3. SHOWER
- 4. KITCHEN
- 5. LAUNDRY

- I.O INSPECTION OPENING
- S.V.P SOIL VENT PIPE
- MH MAN HOLE
- D.P DOWNPIPE
- WM WATER METER
- STORMWATER PIPES

BYRON COUNCIL
DEVELOPMENT CONSENT
THIS IS THE PLAN ATTACHED TO
DEVELOPMENT CONSENT No: 10.2019.338.1
DATED: 14/8/2019
[Signature]
DEVELOPMENT OFFICER